#### Carlyle/Eisenhower East Design Review Board (DRB) Application

PROJECT NAME: Carlyle Block P BLOCK: P	
ADDRESS OF PROJECT: 765 John Carlyle Street and 1900 Eisenhower Avenue	
APPLICATION FOR REVIEW OF: (Check one)  [Mailding Concept ✓ Final  [ ] Sign  [ ] Awning  [ ] Other:	
APPLICANT Name: Jonathan P. Rak, McGuireWoods LLP, on behalf of 765 John Carlyle Senior Living, LLC	;
Address: 1750 Tysons Boulevard, Suite 1800, Tysons VA 22102	
Phone: 703-712-5411 Email Address: <u>jrak@mcguirewoods.com</u>	
ARCHITECT/DESIGNER Name: Perkins Eastman	
Address: One Thomas Circle NW Suite 200, Washington DC 20005	
Phone: 202-971-4969 Email Address: f.basaran@perkinseastman.com	
PROPERTY OWNER Name: 765 John Carlyle Senior Living, LLC (if different from APPLICANT) Address: 1055 Thomas Jefferson Street, NW Suite 600, Washington, DC 20007	
Phone: 202-295-3364 Email Address: wbrewer@trammellcrow.com	
DESCRIBE THE REQUEST BRIEFLY: Approval to minor modifications to the previously approved design of the South Tower of Carlyle Block P.	
The undersigned hereby attests that all of the information herein provided including the site plan, building elevations, prospective drawings of the project, and written descriptive information are true, correct and accurate. The undersigned further understands that, should such information be found incorrect, any action taken by the Board based on such information may be invalidated. The applicant, if other than the property owner, also attests that he/she has obtained permission from the property owner to make this application.  Note: Per condition #67 of the Carlyle SUP #2253, as amended by SUP #2007-0094, all applicants will be responsible for the costs associated with DRB review of the application. Fees are determined based upon the	
number of applicants per hearing. Applicants will be notified by Planning and Zoning staff of the amount owed after the filing deadline has passed and the agenda for the hearing has been finalized. Payment is expected prior to the request being acted upon by the DRB.	
Applicant Signature: p.p. Steven M. Mikulic Date: 1/6/22	
Applicant Printed Name: Jonathan P. Rak	

#### Carlyle/Eisenhower East Design Review Board (DRB) Application Checklist for <u>Buildings in CONCEPT REVIEW\*</u>:

Physical massing model at minimum 1"=30', showing existing and proposed buildings for all
adjacent properties
Submit the following plan copies containing all of the information on this checklist:
Twelve (12) 11"x17" collated, stapled color sets
One (1) 24"x36" collated, stapled, color sets, and
One (1) 11"x17" 120 dpi PDF file
Number all sheets in plan set
Zoning tabulations (for each element, list zoning ordinance requirement and number proposed):
Zoning of the site
Existing uses on the site
Proposed uses for the site
Lot area(s) (and minimum lot area required under zoning, if applicable)
Number of dwelling units (list by number of bedrooms for multifamily)
Units per acre for residential
Gross square feet (GSF) of building area, total and listed by use (with area devoted to parking
included and listed separately)
Net square feet (NSF) of floor area, total and listed by use
Existing and proposed floor-area-ratios
Open space total provided and broken down by ground-level space and usable space provided
Average finish grade for each building
Height of each building above average finish grade
Building setbacks with required and proposed listed separately
Frontage with required and proposed listed separately
Parking spaces (listed by compact, standard, handicapped size and total)
Loading spaces (number required and number proposed)
Site plan/architecture:
Color Site plan at appropriate scale, showing approved uses & heights for adjacent properties
Color Landscape concept plan showing hardscape and planting areas, trees, street furniture, et
Color typical floor plans at min. $1/16$ " = 1'-0" for all levels including roof
Building elevations in color at min. $1/16$ " = 1'-0" of all building faces with materials labeled,
rendered with shadows and keyed to plans
Building/site sections showing grade changes in relationship to buildings and/or retaining wal
rendered with shadows and keyed to plans and showing average finish grade line and heights,
including penthouses
Enlarged details (plan/section/elevation) of typical bays at pedestrian level as required
Street-level perspective views in color
Building solid/void area ratio calculation drawings and tabulations


#### Carlyle/Eisenhower East Design Review Board (DRB) Application Checklist for <u>Buildings in FINAL REVIEW\*</u>:

N/A	_Detailed physical building model at appropriate scale	
	_Submit the following plan copies containing all of th	
	N/A Twelve (12) 11"x17" collated, stapled color	
	N/A One (1) 24"x36" collated, stapled, color sets	, and
	One (1) 11"x17" 120 dpi PDF file	
	Number all sheets in plan set	
<b>-</b>		
Zoning	tabulations (for each element, list zoning ordinance req	uirement and number proposed):
	_Zoning of the site	
<del>/-</del>	_Existing uses on the site	
	_Proposed uses for the site	ng if applicable)
	_Lot area(s) (and minimum lot area required under zoni	
	_Number of dwelling units (list by number of bedrooms	for multifamily)
	_Units per acre for residential	ad by use (with eree deveted to newlying
	_Gross square feet (GSF) of building area, total and listed included and listed separately)	ed by use (with area devoted to parking
1	Net square feet (NSF) of floor area, total and listed by	nga
	Existing and proposed floor-area-ratios	use
	_Den space total provided and broken down by ground	-level space and usable space provided
<del>-</del>	_Open space total provided and broken down by ground _Average finish grade for each building	-level space and usable space provided
	_Height of each building above average finish grade	
	Building setbacks with required and proposed listed se	narately
	_Frontage with required and proposed listed separately	paracery
	Parking spaces (listed by compact, standard, handicapt	ned size and total)
	Loading spaces (number required and number propose	
	_Louding spaces (number required and number propose	u)
Site pla	nn/architecture:	
	Color Site plan at appropriate scale, showing approved	uses & heights for adjacent properties
<del></del>	Color Landscape concept plan showing hardscape and	
	Color typical floor plans at min. $1/16" = 1'-0"$ for all le	
	Building elevations in color at min. $1/16$ " = 1'-0" of all	
	rendered with shadows and keyed to plans	,
<b>✓</b>	Building/site sections showing grade changes in relation	onship to buildings and/or retaining walls,
'	rendered with shadows and keyed to plans and showing	
	including penthouses	
<b>✓</b>	_Street-level perspective views in color	
	Building solid/void area ratio calculation drawings and	tabulations
	Landscape details, referenced to Color Landscape plan	
	Enlarged details (plan/section/elevation) of all building	
	Wall sections with enlarged details indicating different	
N/A	_Additional materials requested by the DRB or material applicable): List:	
	uppriouoie). List.	
*Color a	nd material boards and samples to be provided at Board hearing	
	_Additional materials requested by the DRB or material	s required by conditions of approval (if
	applicable): List:	


#### Carlyle/Eisenhower East Design Review Board (DRB) Application Checklist for Signs, Awnings, Other:

and one (1) 11"x17" (minimum size) collated, stapled color sets (w/pages numbered) and one (1) 11"x17" 120 dpi resolution PDF file of the following:
Color Site plan at a measurable scale showing:
<ul><li>location(s) of proposed element(s)</li></ul>
<ul> <li>dimensions of storefront and building widths [FOR SIGNS &amp; AWNINGS ONLY]</li> <li>Large-scale elevations and sections with enlarged details</li> </ul>
Elevations in color at min. $1/16$ " = 1'-0", with materials labeled, rendered with shadows and keyed to plans
Street-level perspective photomontages in color (daytime view)
Street-level perspective photomontages in color (daytime view) [FOR SIGNS ONLY]  Additional materials requested by the DRB or materials required by conditions of approval (if applicable): List:
gn guidelines (provide information needed to assess compliance):
If located within the Carlyle CDD, information required by the Carlyle Design Guidelines and the
Carlyle Streetscape Design Guidelines
If located in the Eisenhower East CDD, information required by the Eisenhower East Design


# DECEMBER 01, 2021 DESIGN REVIEW BOARD SUBMISSION

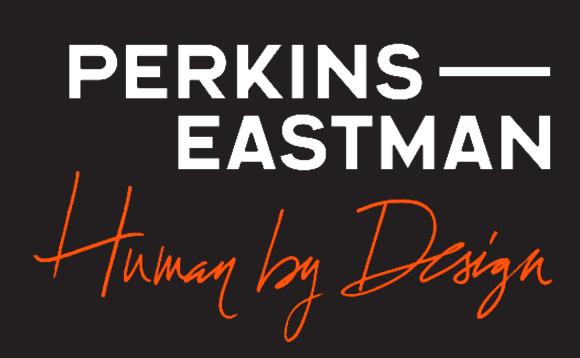

## 765 JOHN CARLYLE - SOUTH TOWER

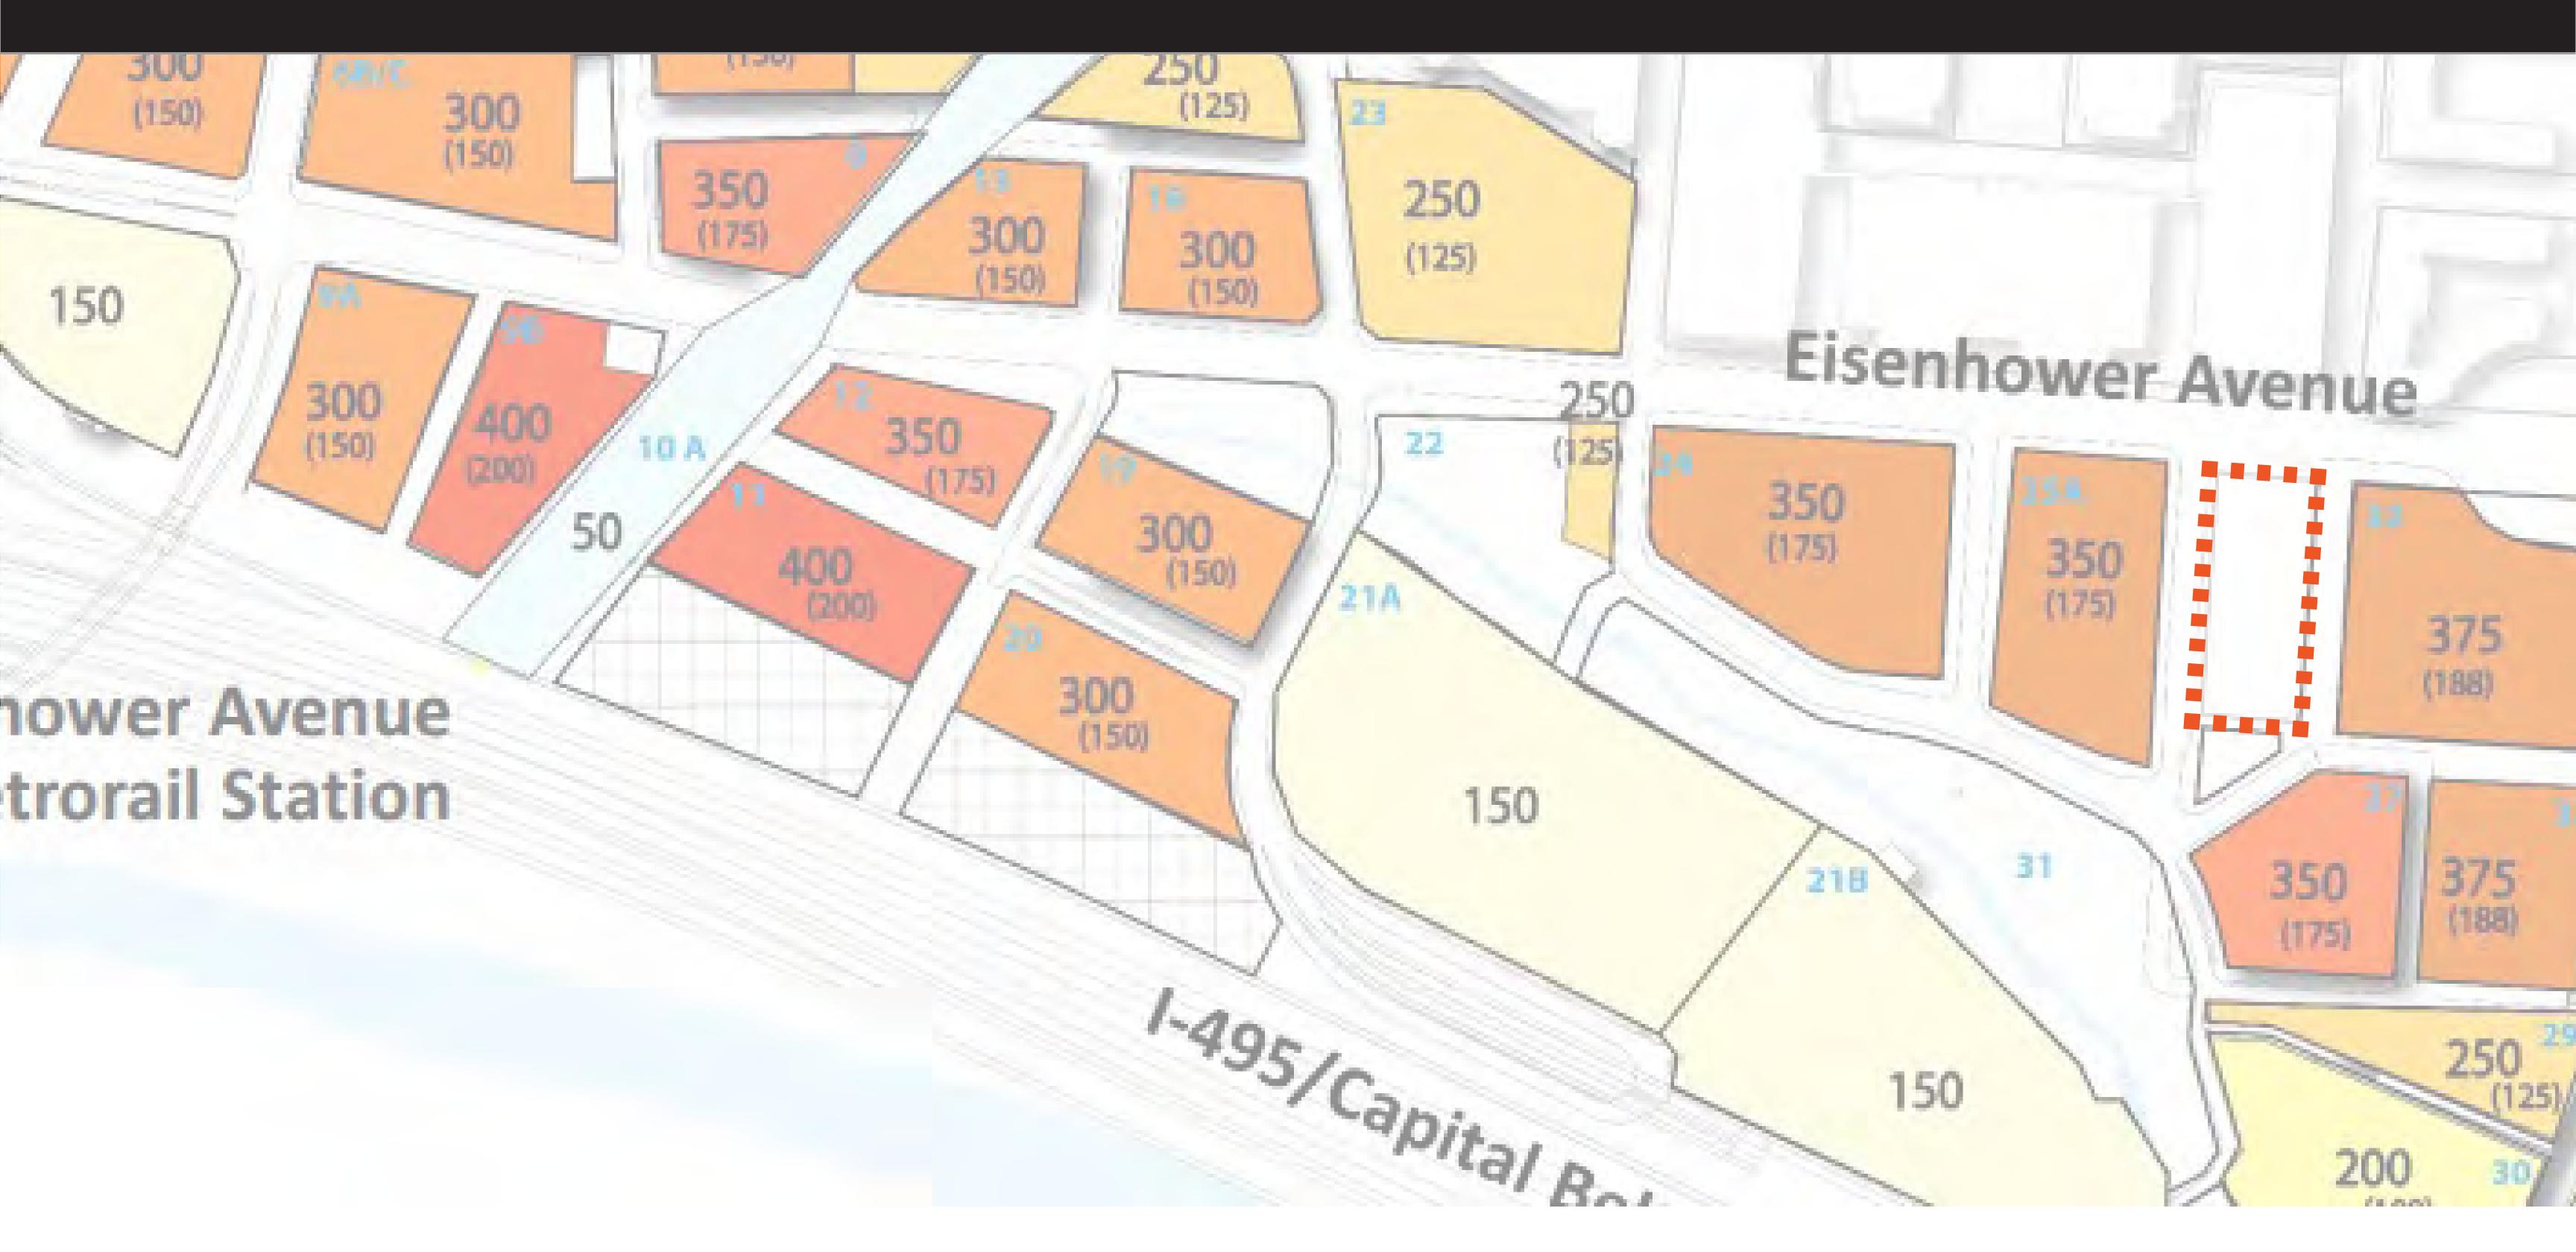


## PROPOSED MODIFICATIONS

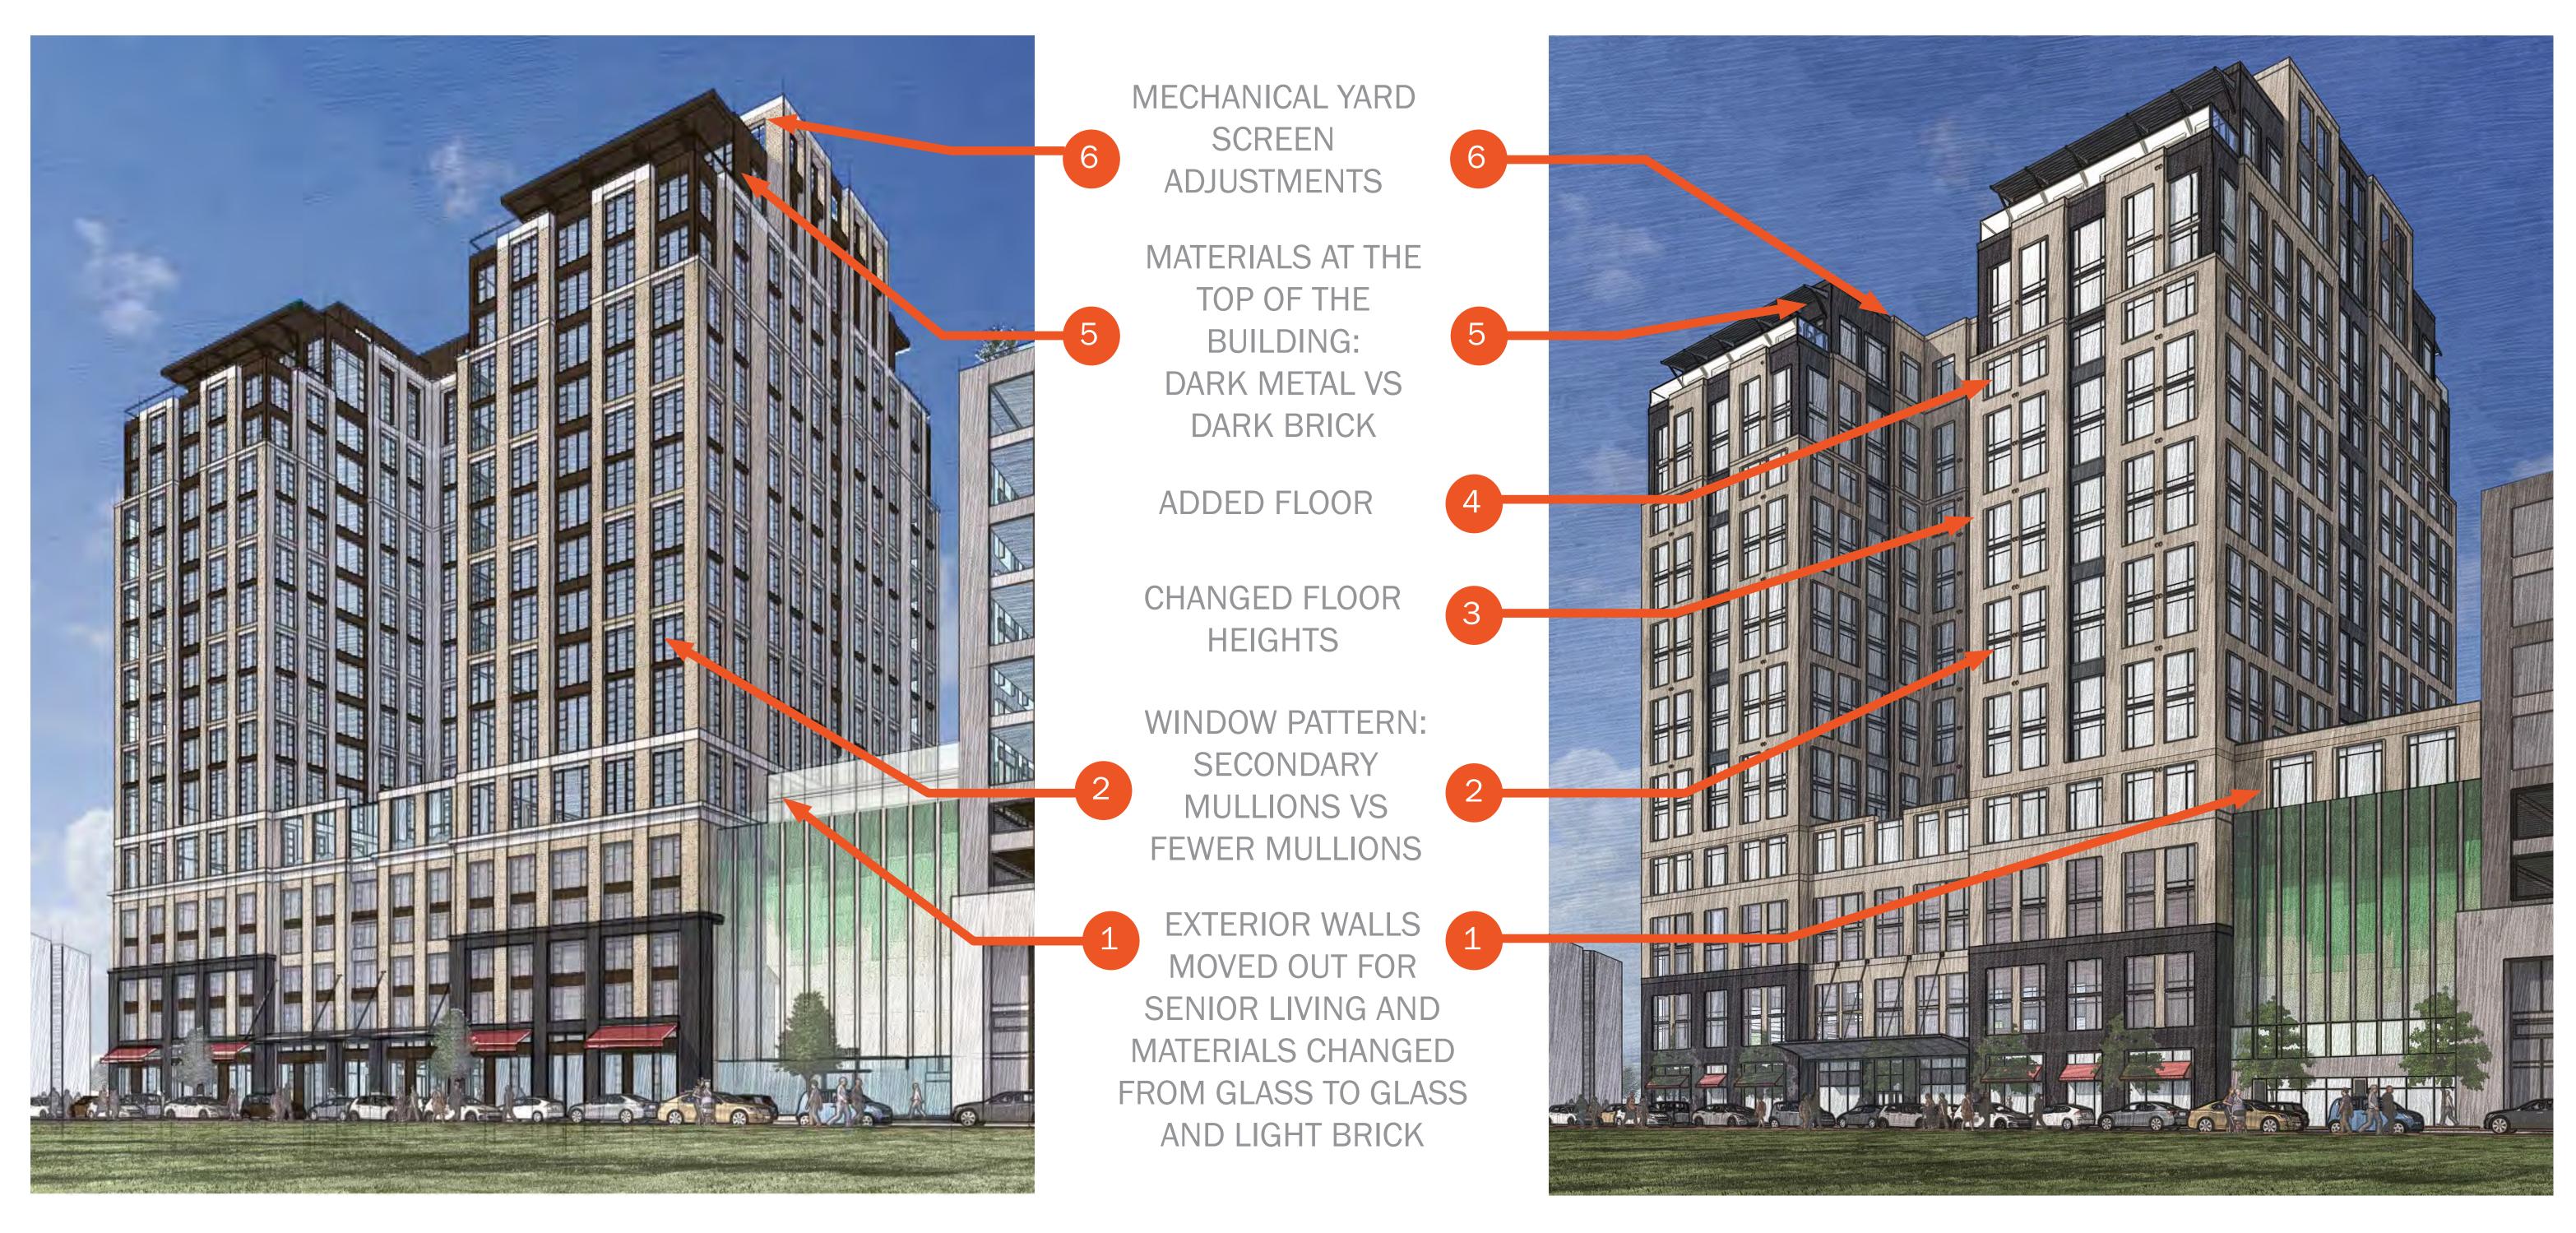

PREVIOUS PROPOSED

#### NORTHEAST VIEW OF SOUTH TOWER - PROPOSED AND PREVIOUS

<sup>\*</sup>Previous building materials and colors are unchanged unless noted as new.

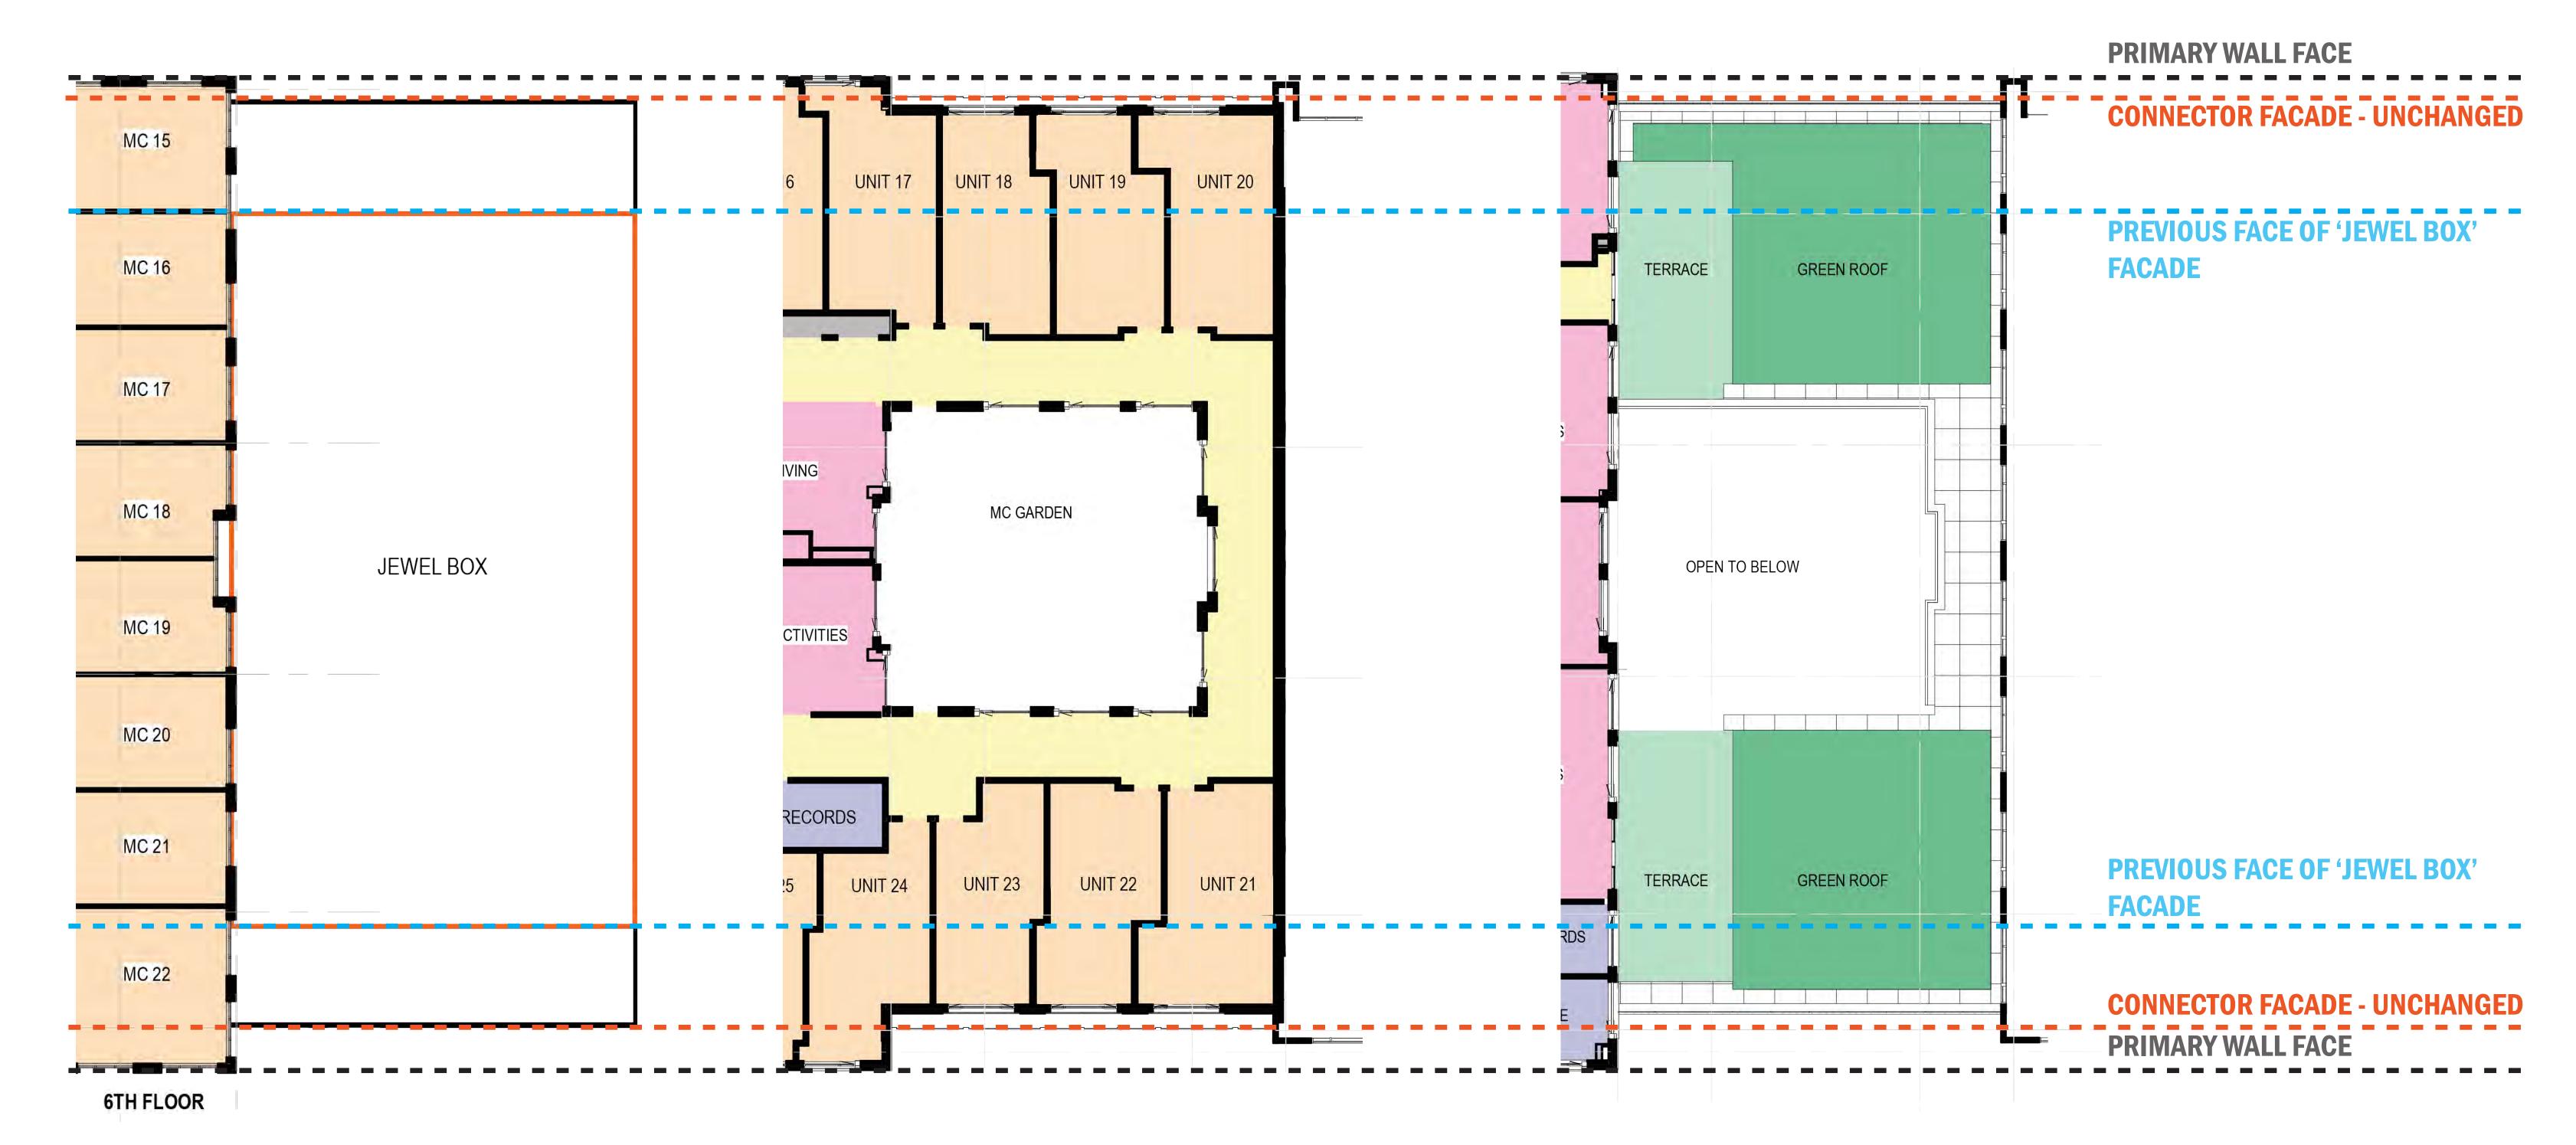

PREVIOUS 6TH FLOOR PLAN

PROPOSED 6TH FLOOR PLAN

CURRENT 7TH FLOOR PLAN (CONNECTOR ROOF)

ALTERATIONS TO APPROVED DESIGN:


- Residential facade has solid elements to acommodate demising walls
- Planted terraces on 6th and 7th floors
- EAST/WEST facades on 6th level have been pushed outward to accomodate residential units inside






PREVIOUS ELEVATION PROPOSED ELEVATION




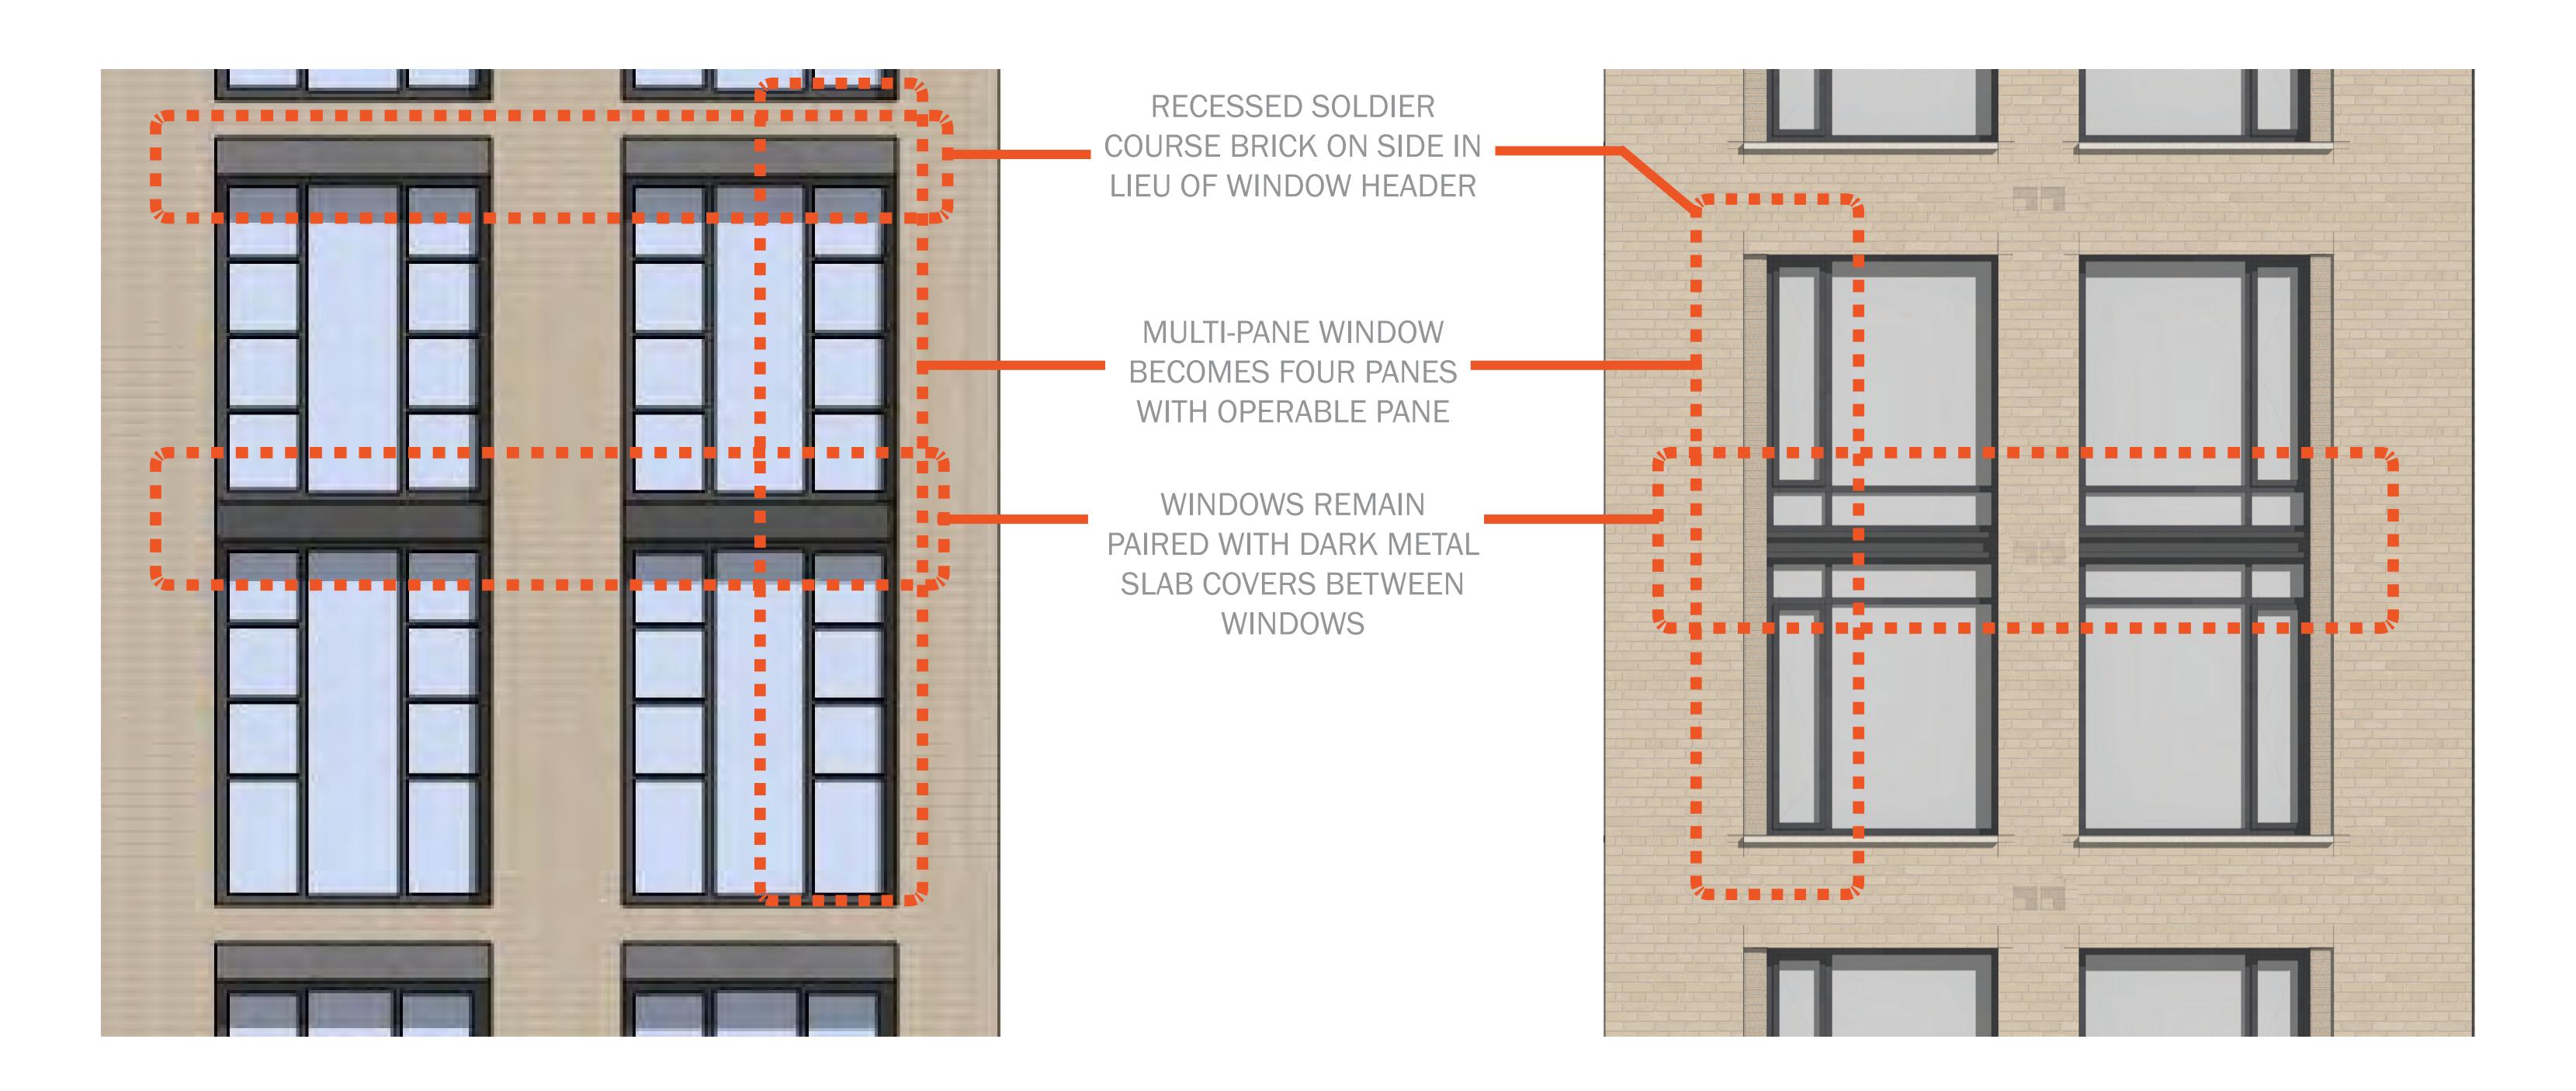

PREVIOUS



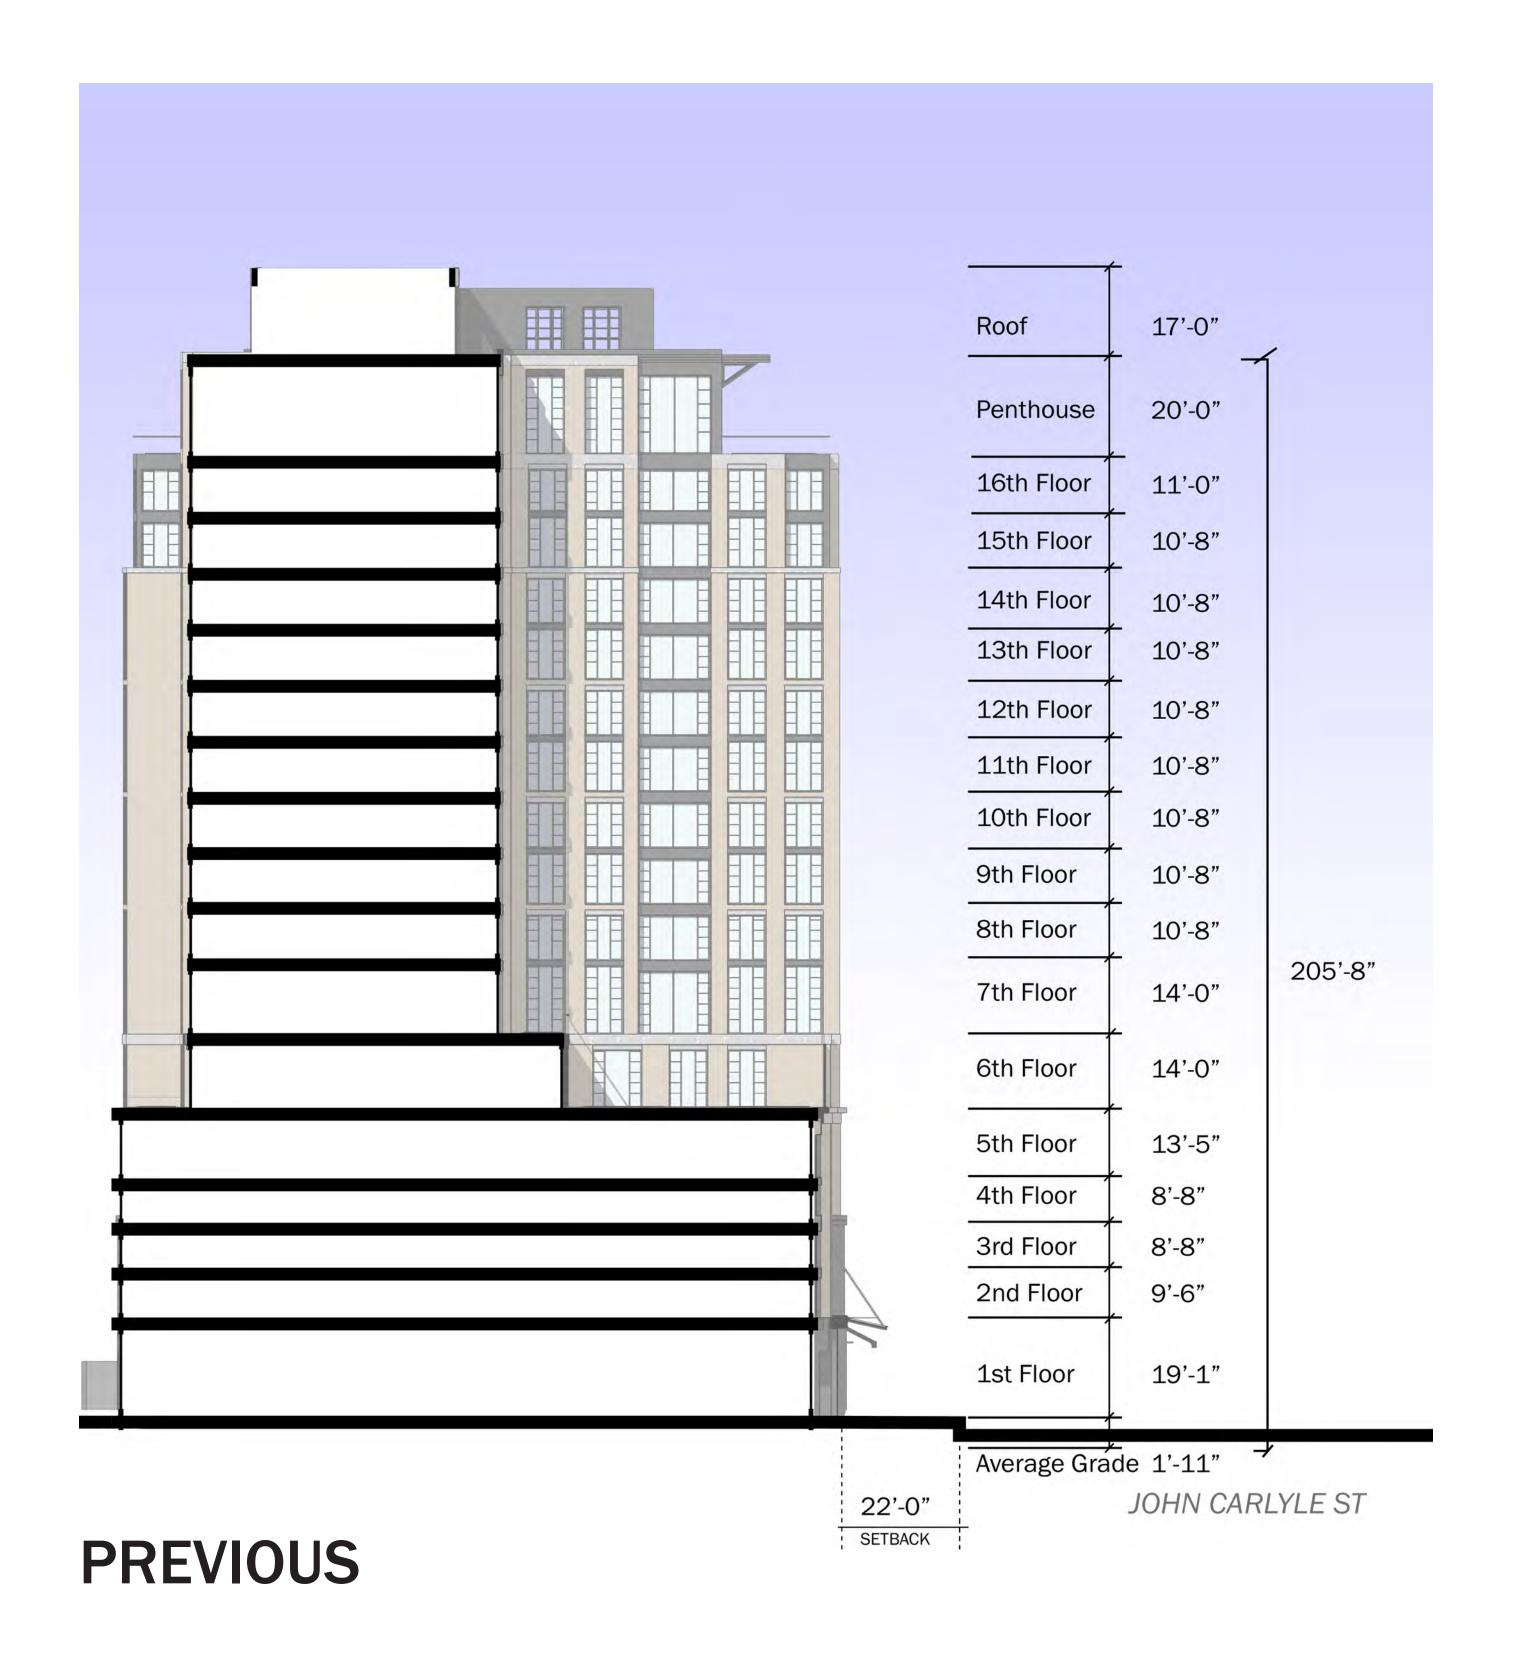

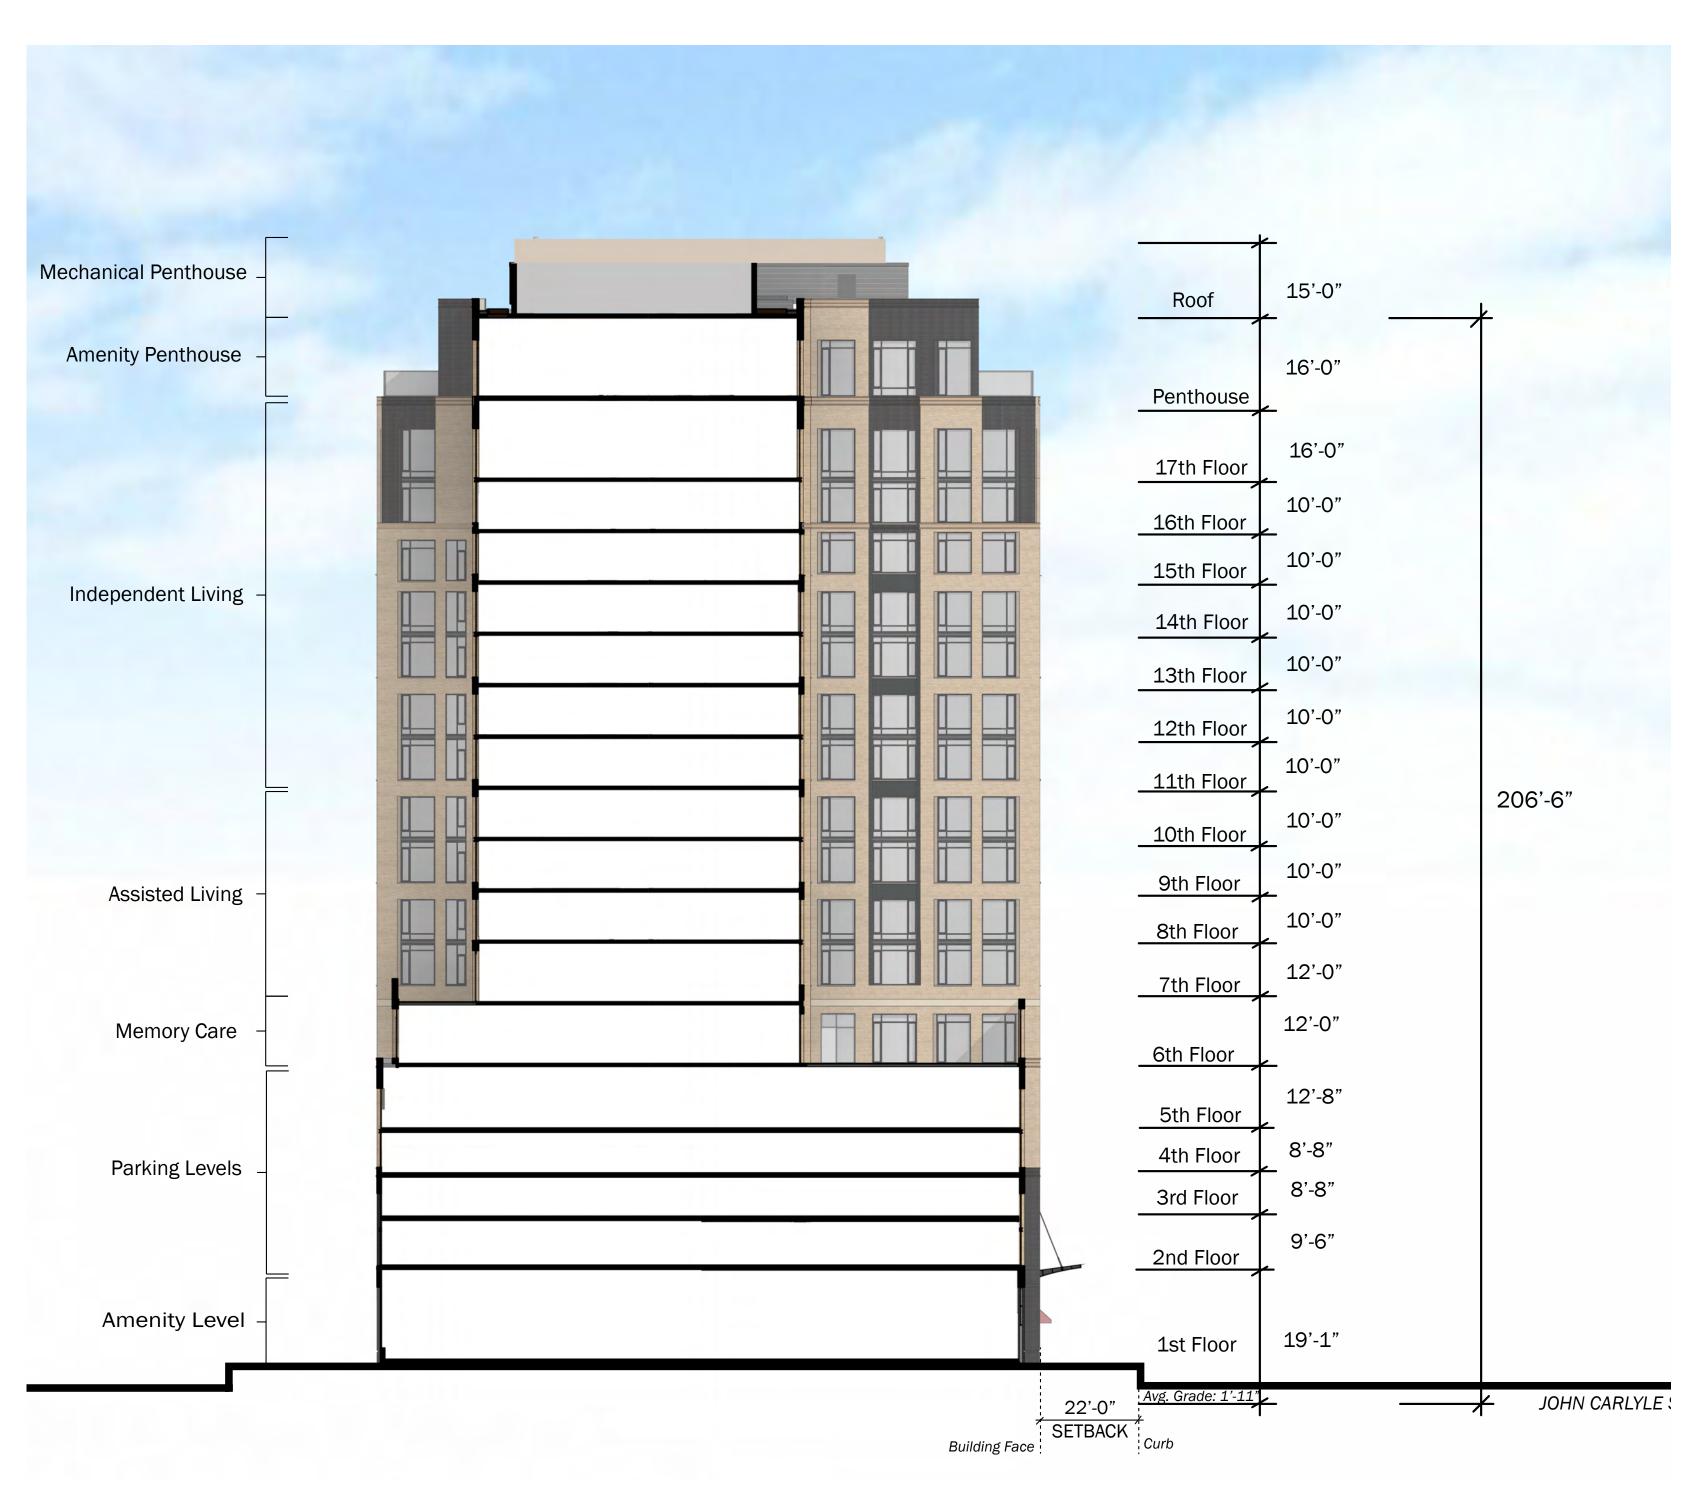

**PROPOSED** 

## **5** FLOOR TO FLOOR HEIGHT COMPARISON



WINDOW PATTERN
REVISED AT FLOOR 15
FOR ADDED FLOOR




**PROPOSED** 

**PREVIOUS** 

4 ADDITIONAL FLOOR

<sup>\*</sup>Previous building materials and colors are unchanged unless noted as new.

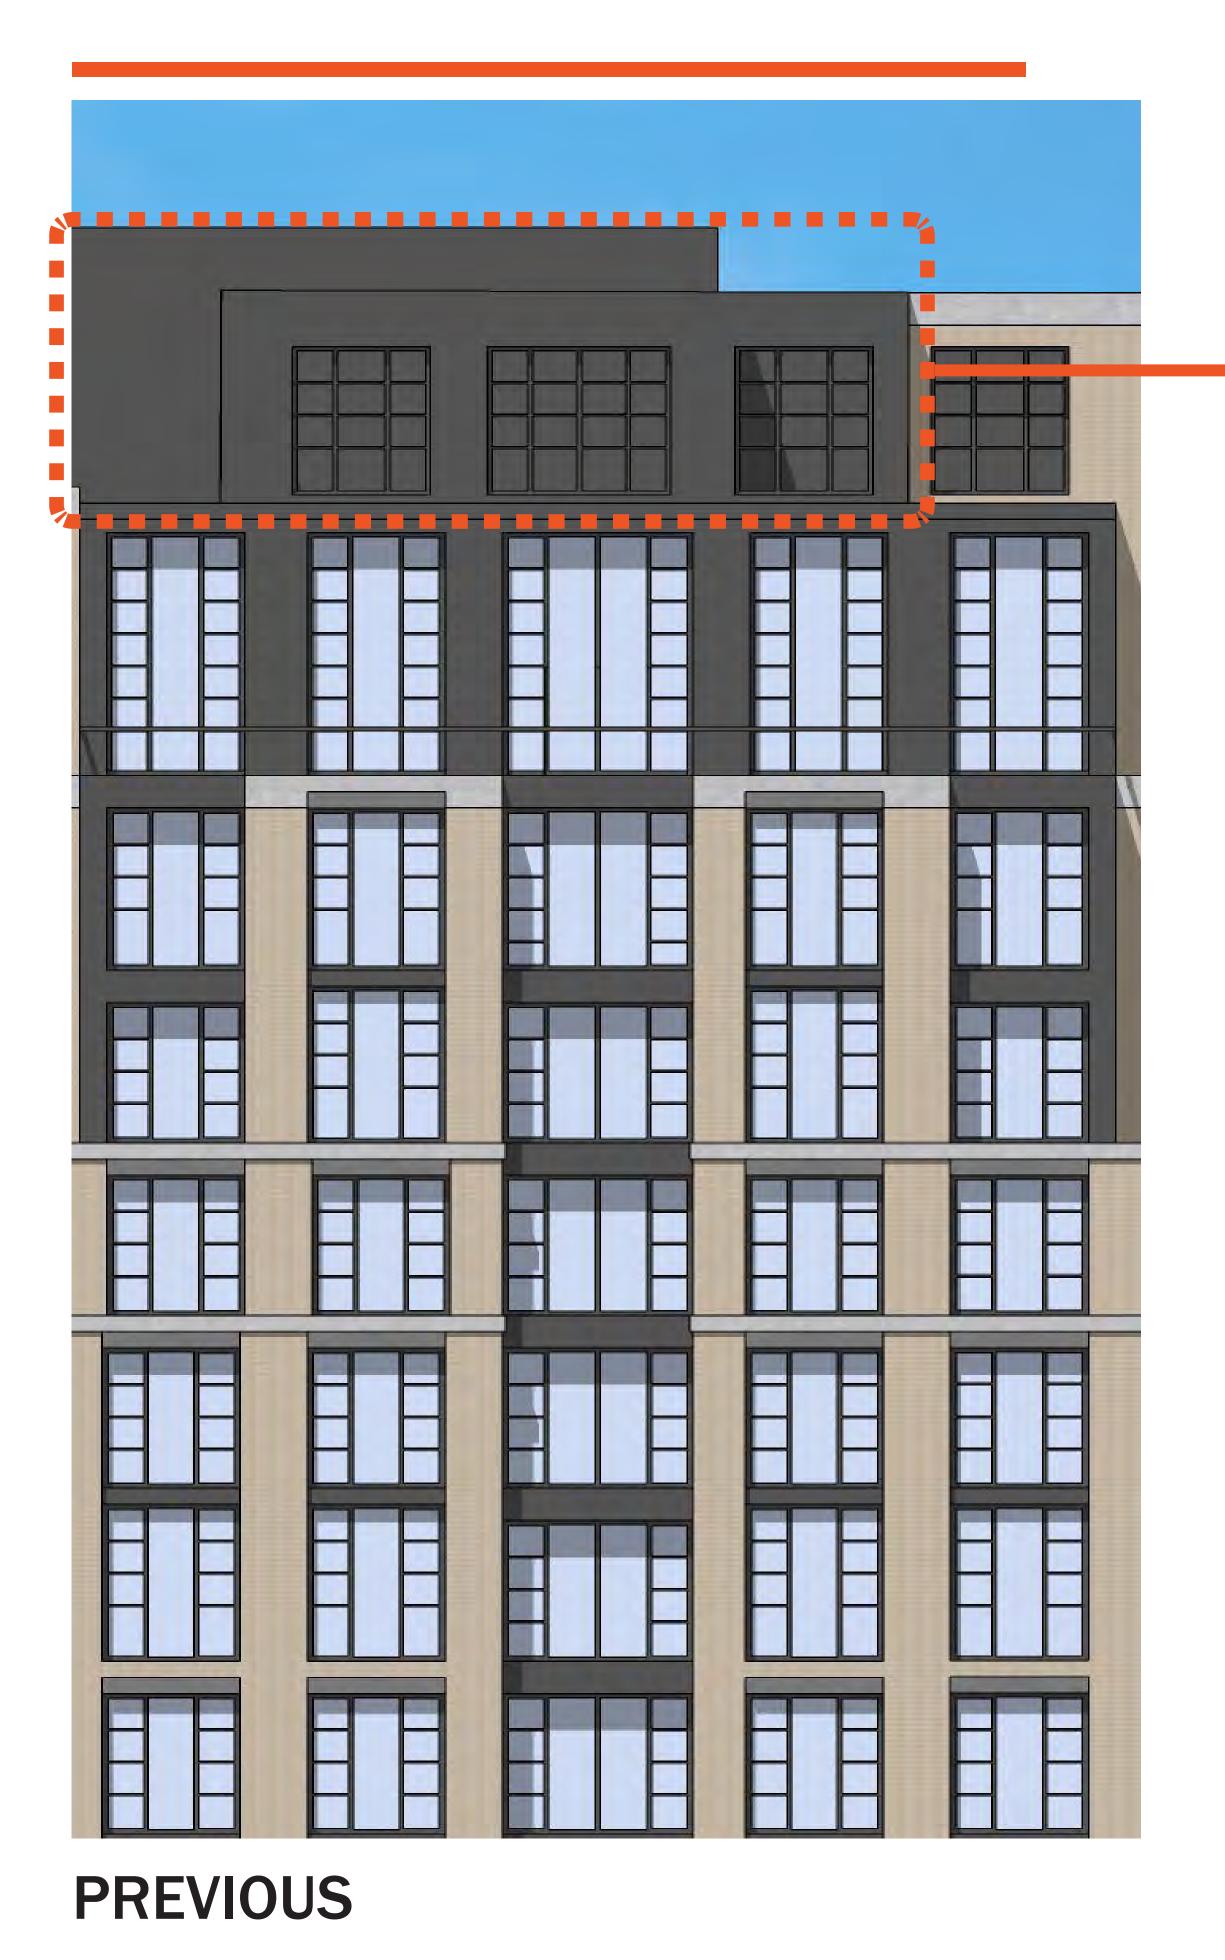


CHANGED FROM
METAL TO FIBER
CEMENT PANEL WITH COLOR
TO MATCH LIGHT BRICK AND
ELIMINATED OPENINGS




**PROPOSED** 



<sup>\*</sup>Previous building materials and colors are unchanged unless noted as new.

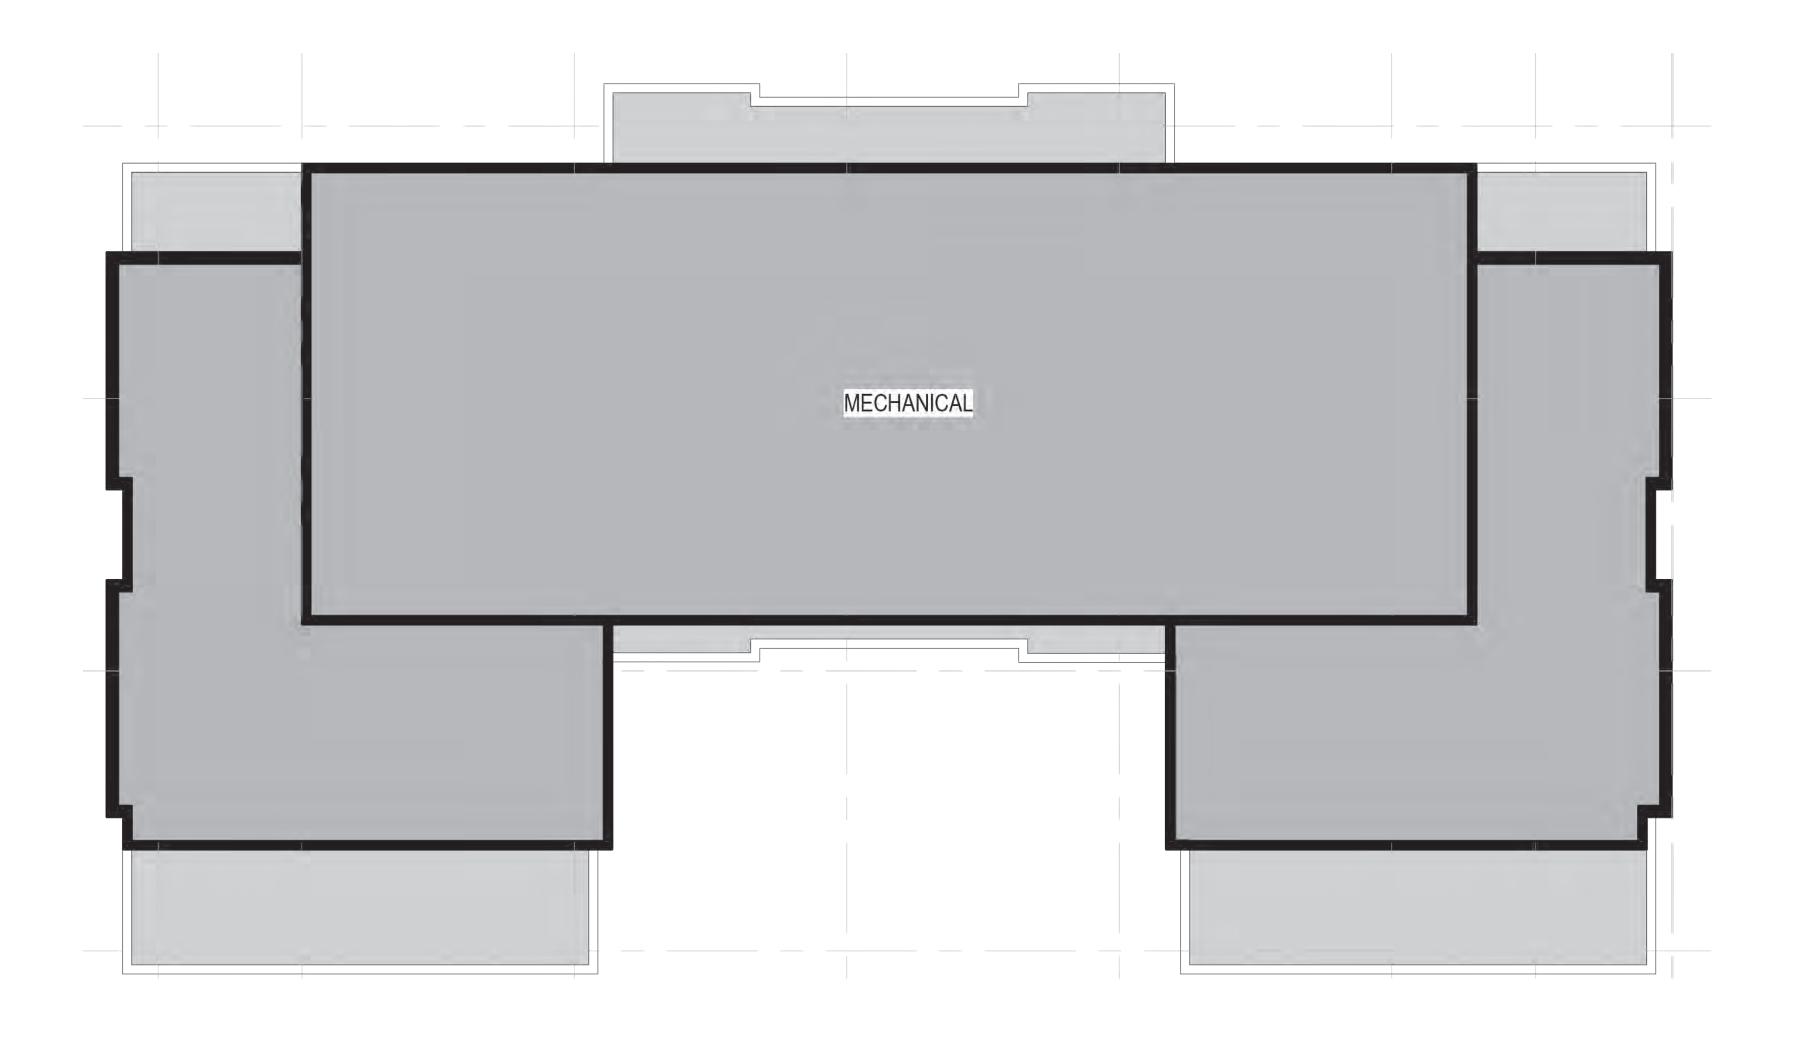

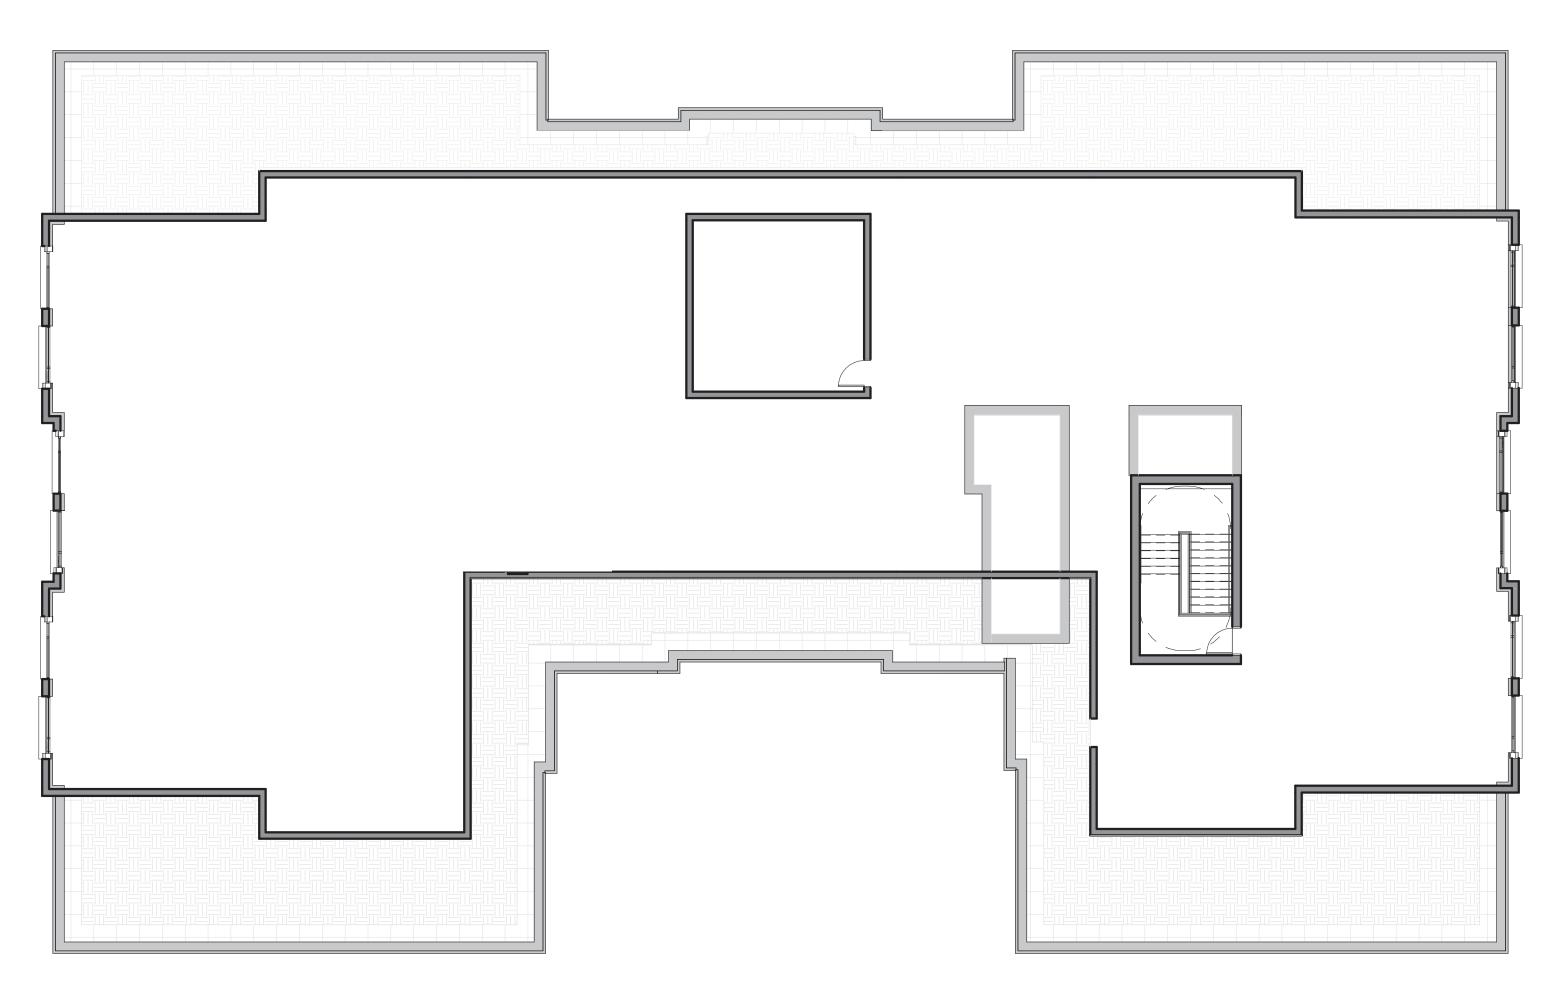

#### PREVIOUS MECHANICAL ENCLOSURE

PROPOSED MECHANICAL ENCLOSURE

#### ALTERATIONS TO APPROVE:

- Revised the layout to accomodate defined equipment
- Changed screen wall height from 17' to 15'









LIGHT BRICK



DARK BRICK




**PROPOSED** 



**PREVIOUS** 


#### **BUILDING MATERIALS - LOWER FLOORS**

#### **NEW**

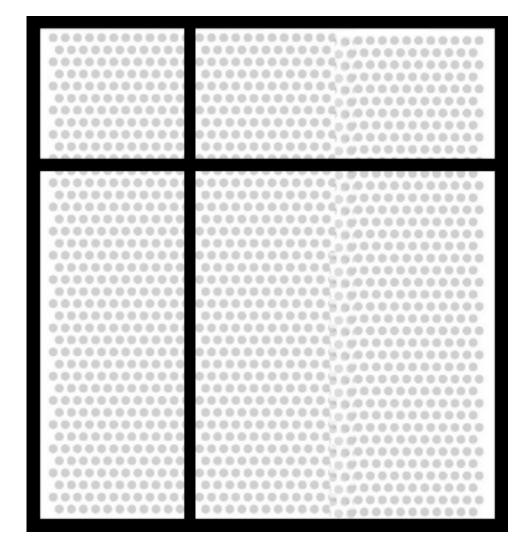

PROPOSED MODIFICATION: CHANGE
WINDOW FRAME FROM MULTI-PANE TO
FOUR PANE TO MATCH THE WINDOW
CHANGES ABOVE

#### **PREVIOUS**

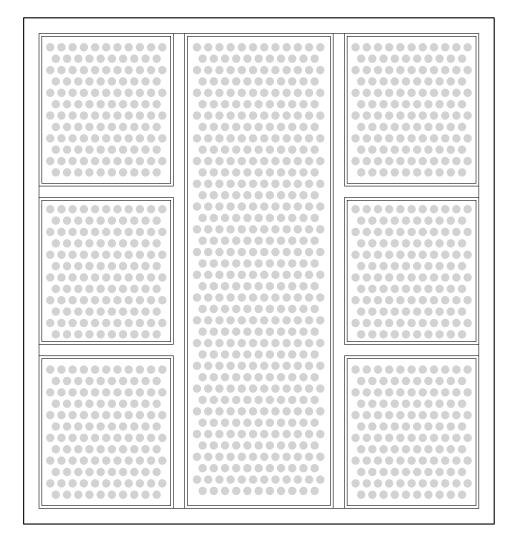

PREVIOUS APPROACH: PEFORATED PANEL PATTERN MODELS WINDOW FRAME

<sup>\*</sup>Previous building materials and colors are unchanged unless noted as new.




DARK METAL SLAB EDGE COVERS, CANOPY, AND WINDOW FRAMES



LIGHT BRICK



DARK BRICK

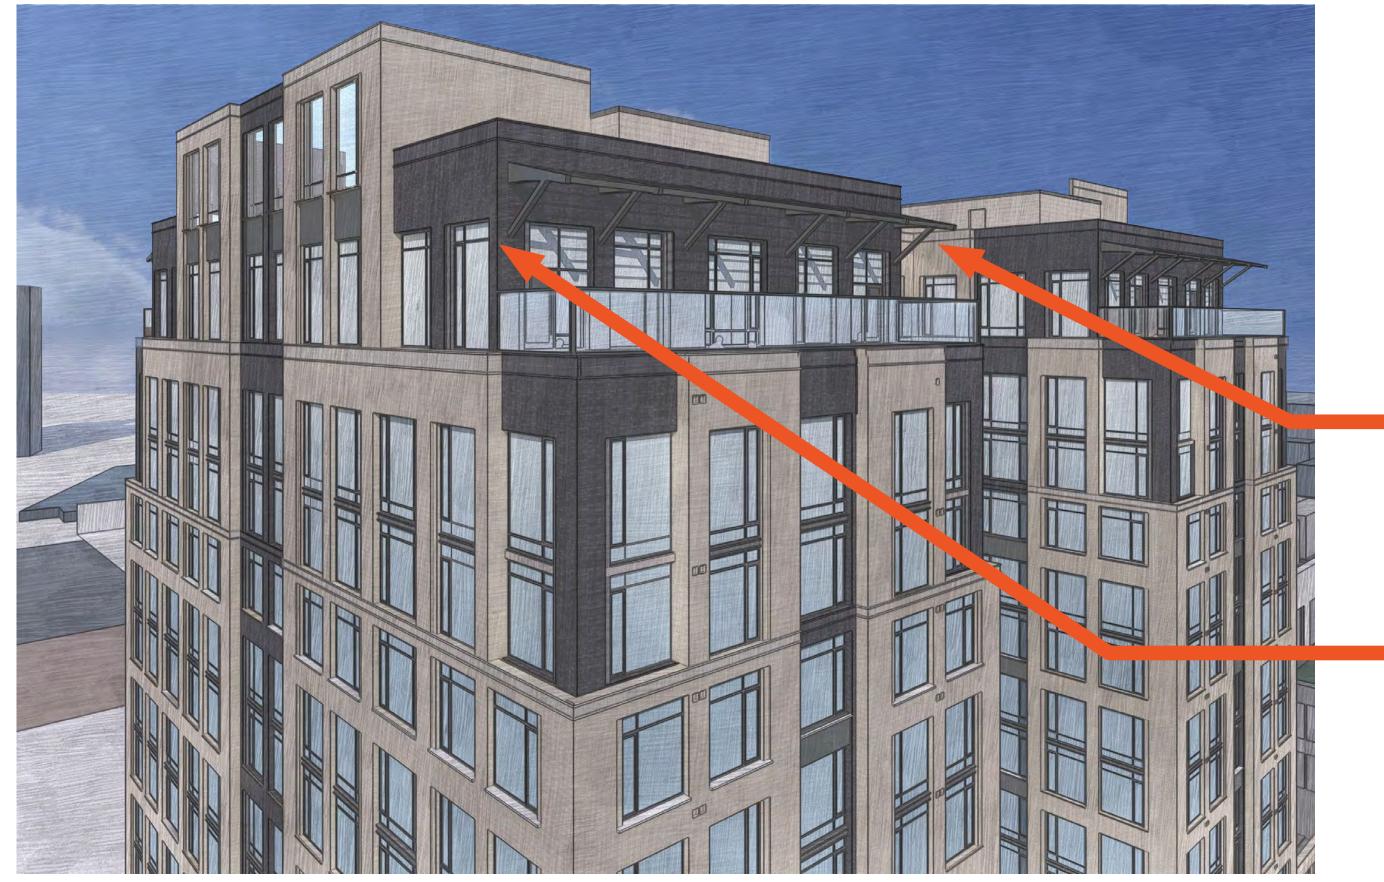

**PROPOSED** 



**PREVIOUS** 

#### **BUILDING MATERIALS - UPPER FLOORS**

**NEW** 

FIBER CEMENT PANEL AT

MATCH LIGHT BRICK

18TH FLOORS

MECHANICAL YARD - COLOR TO

DARK METAL PANEL CHANGED

TO DARK BRICK ON 16, 17 &

<sup>\*</sup>Previous building materials and colors are unchanged unless noted as new.



### NORTHEAST VIEW OF SOUTH TOWER - PREVIOUS



#### NORTHEAST VIEW OF SOUTH TOWER - PROPOSED




#### EAST ELEVATION PROPOSED

\*Previous building materials and colors are unchanged unless noted as new.




#### WEST ELEVATION PROPOSED

<sup>\*</sup>Previous building materials and colors are unchanged unless noted as new.

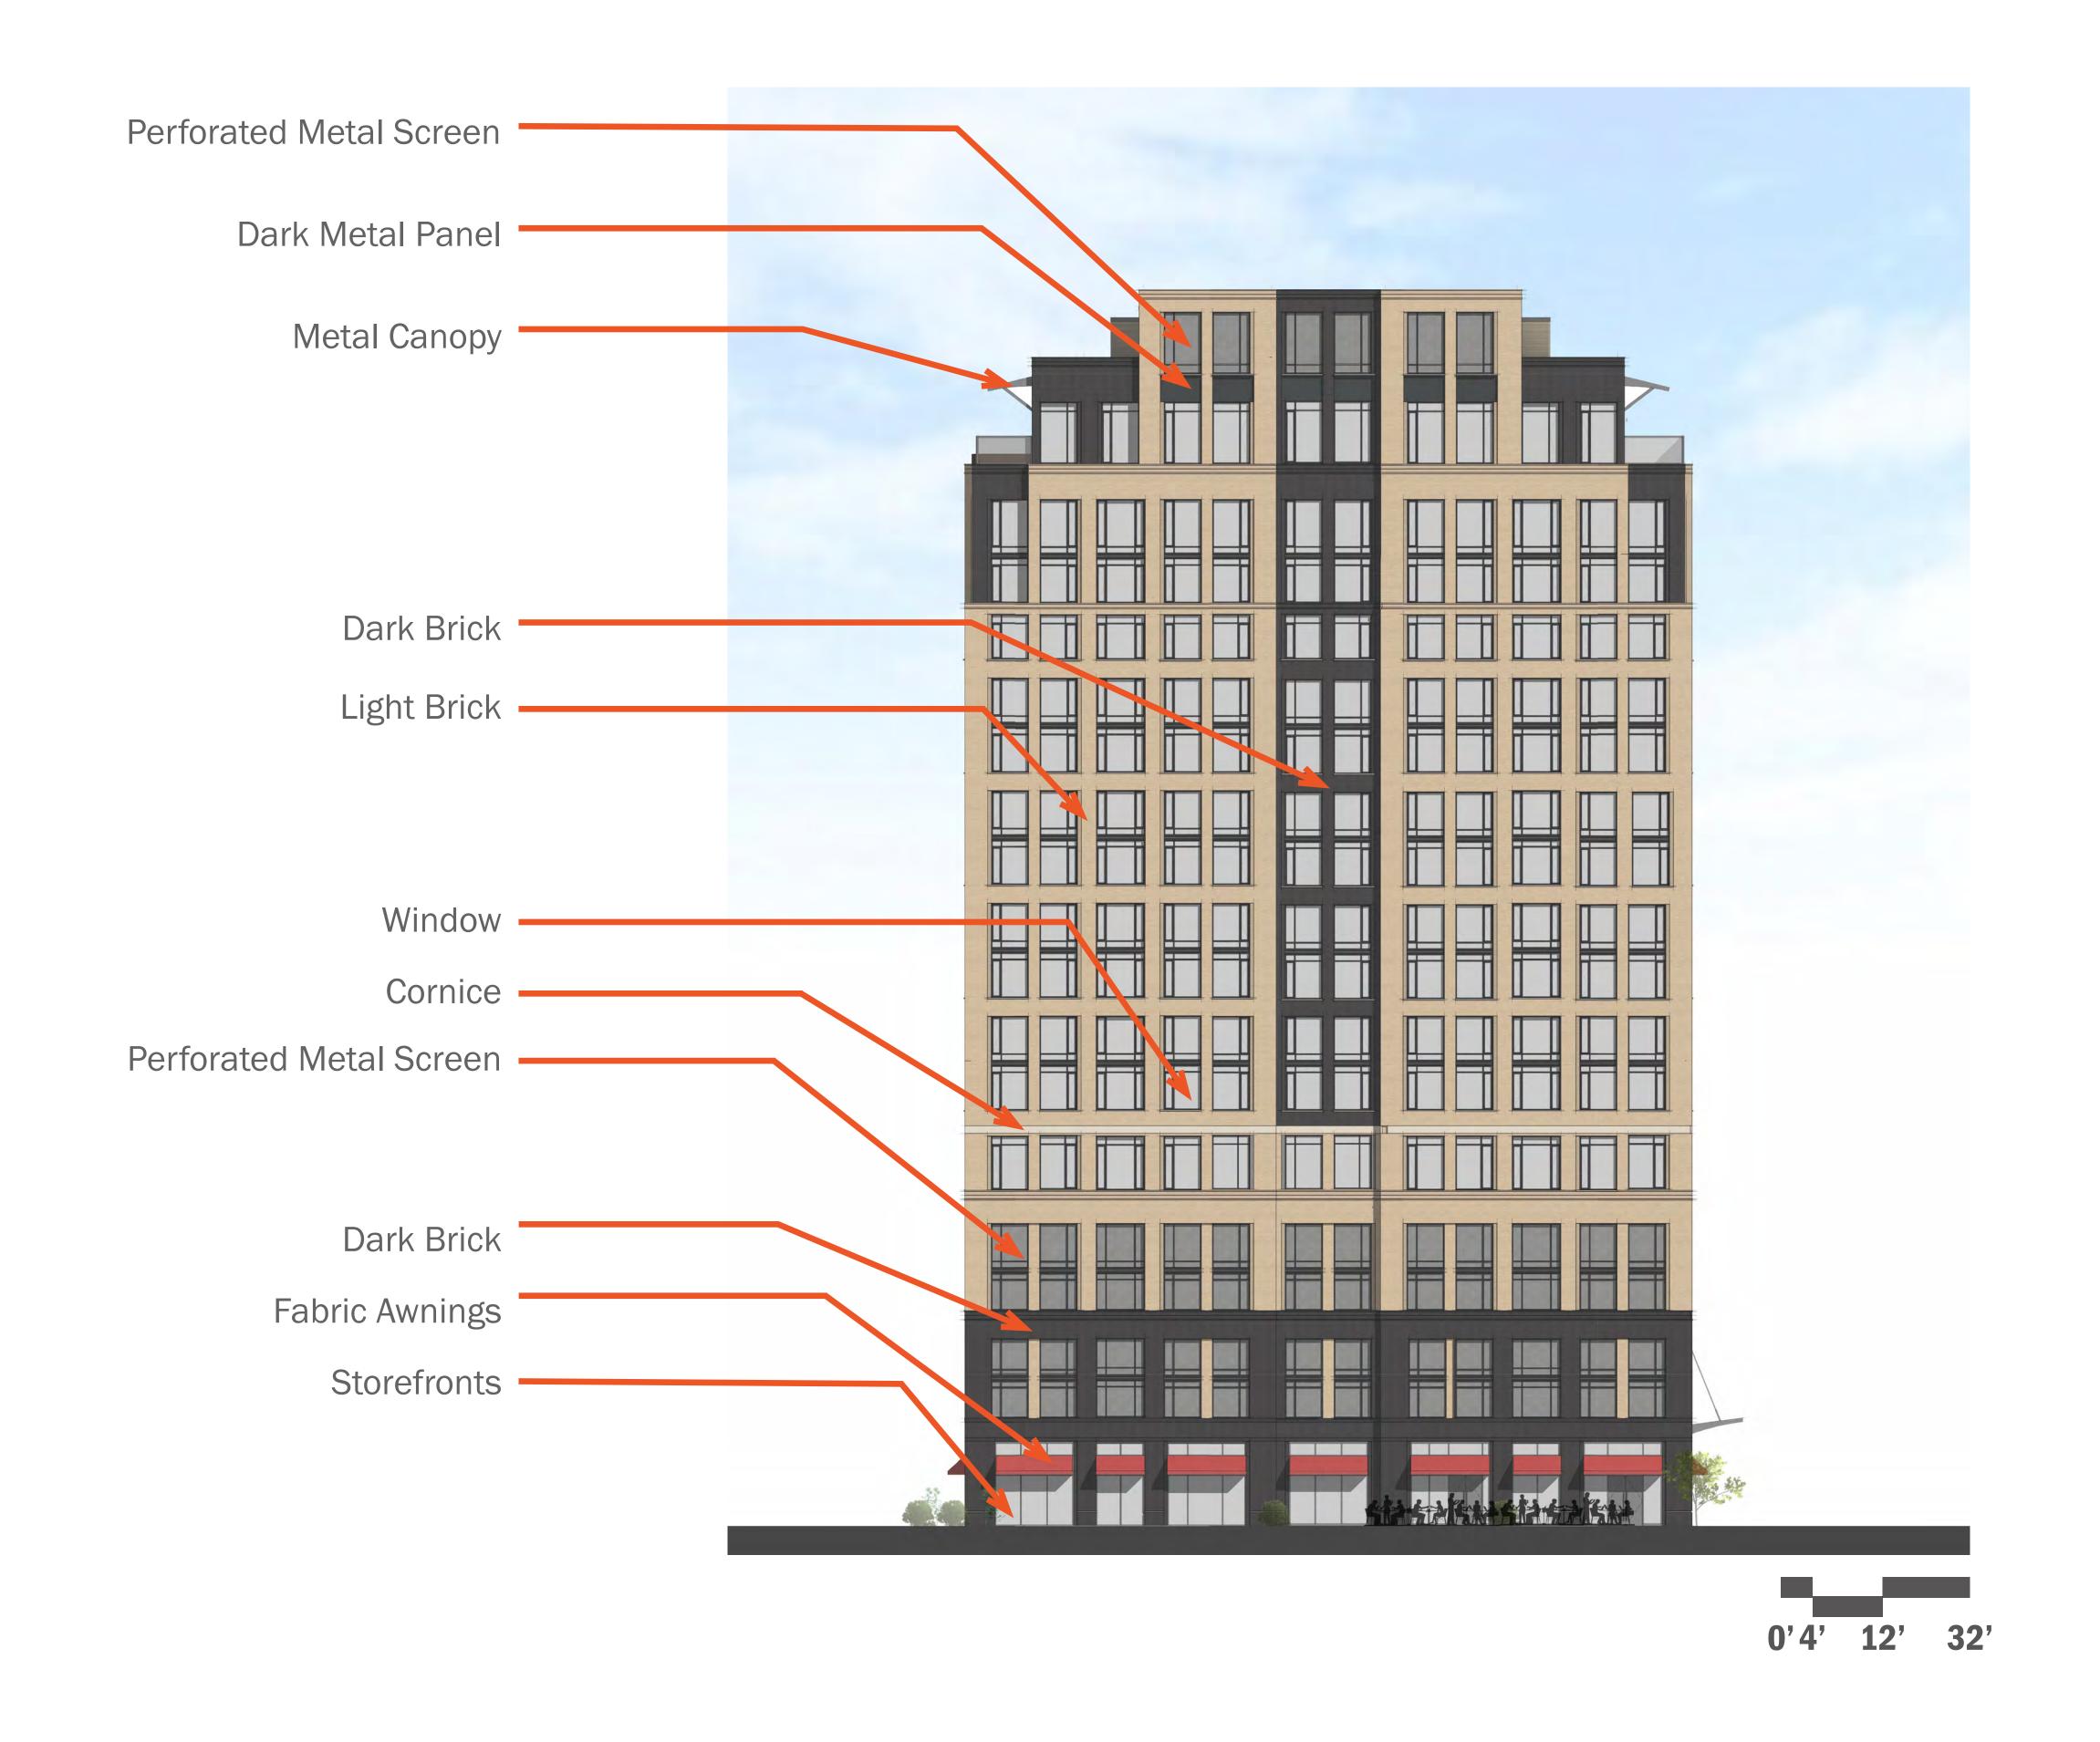

## SOUTH ELEVATION PROPOSED

<sup>\*</sup>Previous building materials and colors are unchanged unless noted as new.

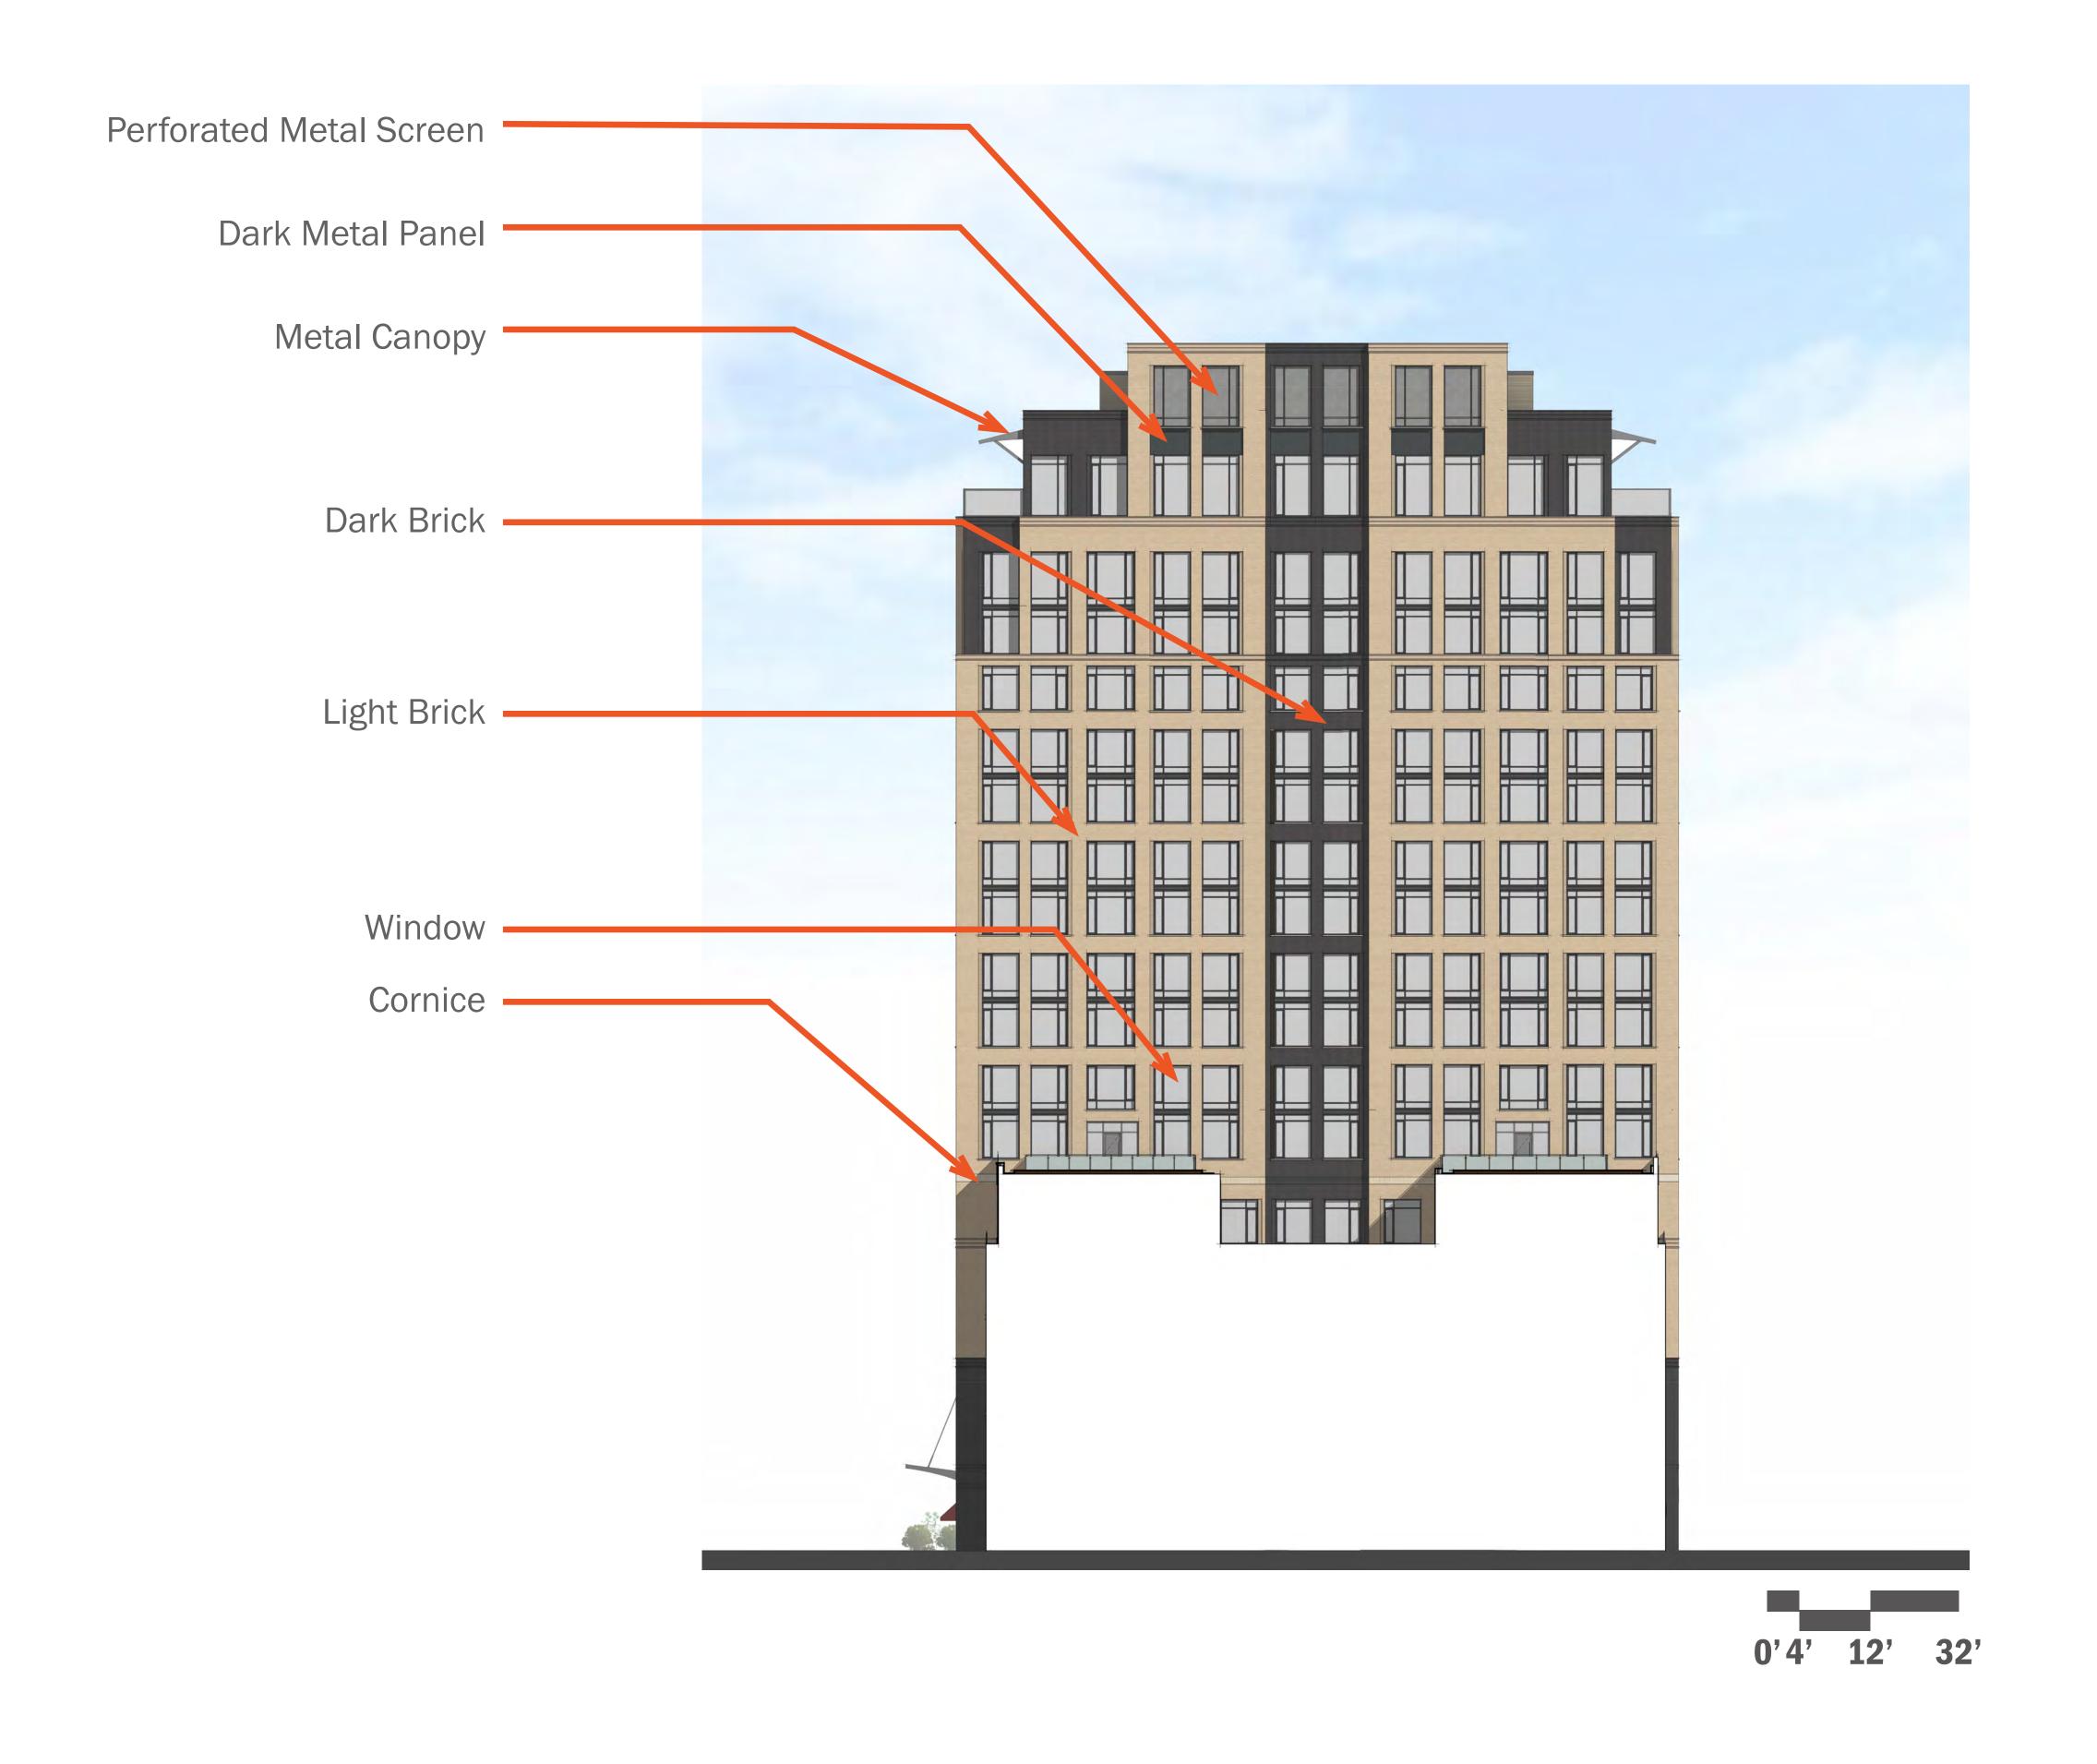

## NORTH ELEVATION PROPOSED

<sup>\*</sup>Previous building materials and colors are unchanged unless noted as new.

## SUPPORTING IMAGES

#### **ZONING SUMMARY**

#### **PROJECT LOCATION**

LOT 72, BLOCK - P

THE PROJECT IS BOUNDED BY EISENHOWER AVENUE TO THE NORTH, HOOFF'S RUN DRIVE TO THE WEST, AN APARTMENT BUILDING TO THE SOUTH, AND THE EXTENSION OF JOHN CARLYLE STREET TO THE EAST

#### **AREA TABULATIONS**

TOTAL SITE AREA = 2.18 AC (94,905 SF)\*

TOTAL EXISTING IMPERVIOUS AREA = 0.00 AC (00,000 SF)

TOTAL PROPOSED IMPERVIOUS AREA = 2.14 AC (93,110 SF)

TOTAL DISTURBED AREA = 3.77 AC (164,322 SF)

\*INCLUDES BUILDING AND JOHN CARLYLE STREET

#### **ZONING TABULATIONS**

**ZONE OF SITE:** CDD#1 WITH CARLYLE SUP #2006-0042

USE: <u>EXISTING</u> <u>PROPOSED</u>

VACANT OFFICE - SENIOR LIVING - RETAIL

**LOT AREA:** 85,693 SF

#### **GROSS FLOOR AREA:**

Γ	GROSS FLOOR AREAS (sf)				EXCLUSIONS	EXCLUSIONS	EXCLUSIONS		
LEVEL	OFFICE	SENIOR LIVING	PARKING	RETAIL	PH	SENIOR LIVING	OFFICE	PARKING	TOTAL NET GFA
GROUND	11,434	22,125		12,025		6,160	3,836		35,588
P1			47,767					47,767	0
P2			48,152					48,152	0
P3			48,182					48,182	0
P4			47,401					47,401	0
6	19,145	22,571				3,452	1,432		36,832
7	19,270	21,274				4,443	1,472		34,629
8	19,270	18,744				1,723	1,510		34,781
9	19,270	18,744				1,723	1,549		34,742
10	15,400	18,744				1,723	1,549		30,872
PH-NORTH					1,005		1,005		0
11		18,746				1,801			16,945
12		18,746				1,801			16,945
13		18,746				1,801			16,945
14		18,746				1,801			16,945
15		18,746				1,801			16,945
16		18,746				1,801			16,945
17		18,746				1,801			16,945
PH-SOUTH					15,784	1,528			14,256
TOTAL	103,789	253,424	191,502	12,025	16,789	33,359	12,353	191,502	340,315

FLOOR AREA RATIOEXISTINGPROPOSEDN/A3.59 (FULL BLOCK P SITE)

40% = 26,277 SF

OPEN SPACE REQUIRED PROVIDED

GROUND LEVEL 13,114 SF
SIXTH FLOOR 4,484 SF
ROOF TERRACE 10,000 SF

TOTAL PROVIDED 27,598 SF = 42%

AVERAGE FINISHED GRADE 30.07'

<u>HEIGHT</u>

STORIES HEIGHT AVERAGE FINISH GRADE
TOTAL HEIGHT ALLOWED UNDER CARLYLE SUP 10-15 200
TOTAL HEIGHT PROPOSED

 NORTH TOWER
 10\*
 121.01'
 30.07

 SOUTH TOWER
 18\*
 205.67'
 30.07

TOTAL PROPOSED SUBGRADE PARKING LEVELS 0

\* LAST OCCUPIED LEVEL

**SETBACKS** 

PROPOSED AS REQUIRED BY CARLYLE SUP #2006-0042

FRONT 22' JOHN CARLYLE STREET (TO FACE OF CURB)

SIDE 42' EISENHOWER AVENUE (TO EX. ROW)

SIDE 30' PROPOSED FIRE LANE (TO EX. PROPERTY LINE)

REAR NONE HOOF'S RUN (TO EX. FACE OF CURB)

FRONTAGE REQUIRED PROPOSED

N/A N/A

**PARKING REQUIRED** 

WITHIN ENHANCED TRANSIT AREA

 Office
 0.25/1000 SF
 1.5/1000 Sf
 103,789
 26
 156

 Retail
 0.25/1,000 SF
 3/1,000 SF
 12,025
 4
 37

 Office/Retail Sub-Total
 30
 193

 Min
 Max
 # of Units
 Min Parking Parking
 Parking

 Senior Living
 1 per 2 units
 N/A
 186
 93
 N/A

Senior Living Sub-Total

Total Parking Requirements 123 N/A

**PARKING PROVIDED** 

 COMPACT
 259

 STANDARD
 150

 ADA
 14

 ADA VAN
 5


 TOTAL
 428

LOADING SPACES REQUIRED PROVIDED

**DWELLING UNITS** 

TOTAL UNITS 186


UNITS PER ACRE 85.3211

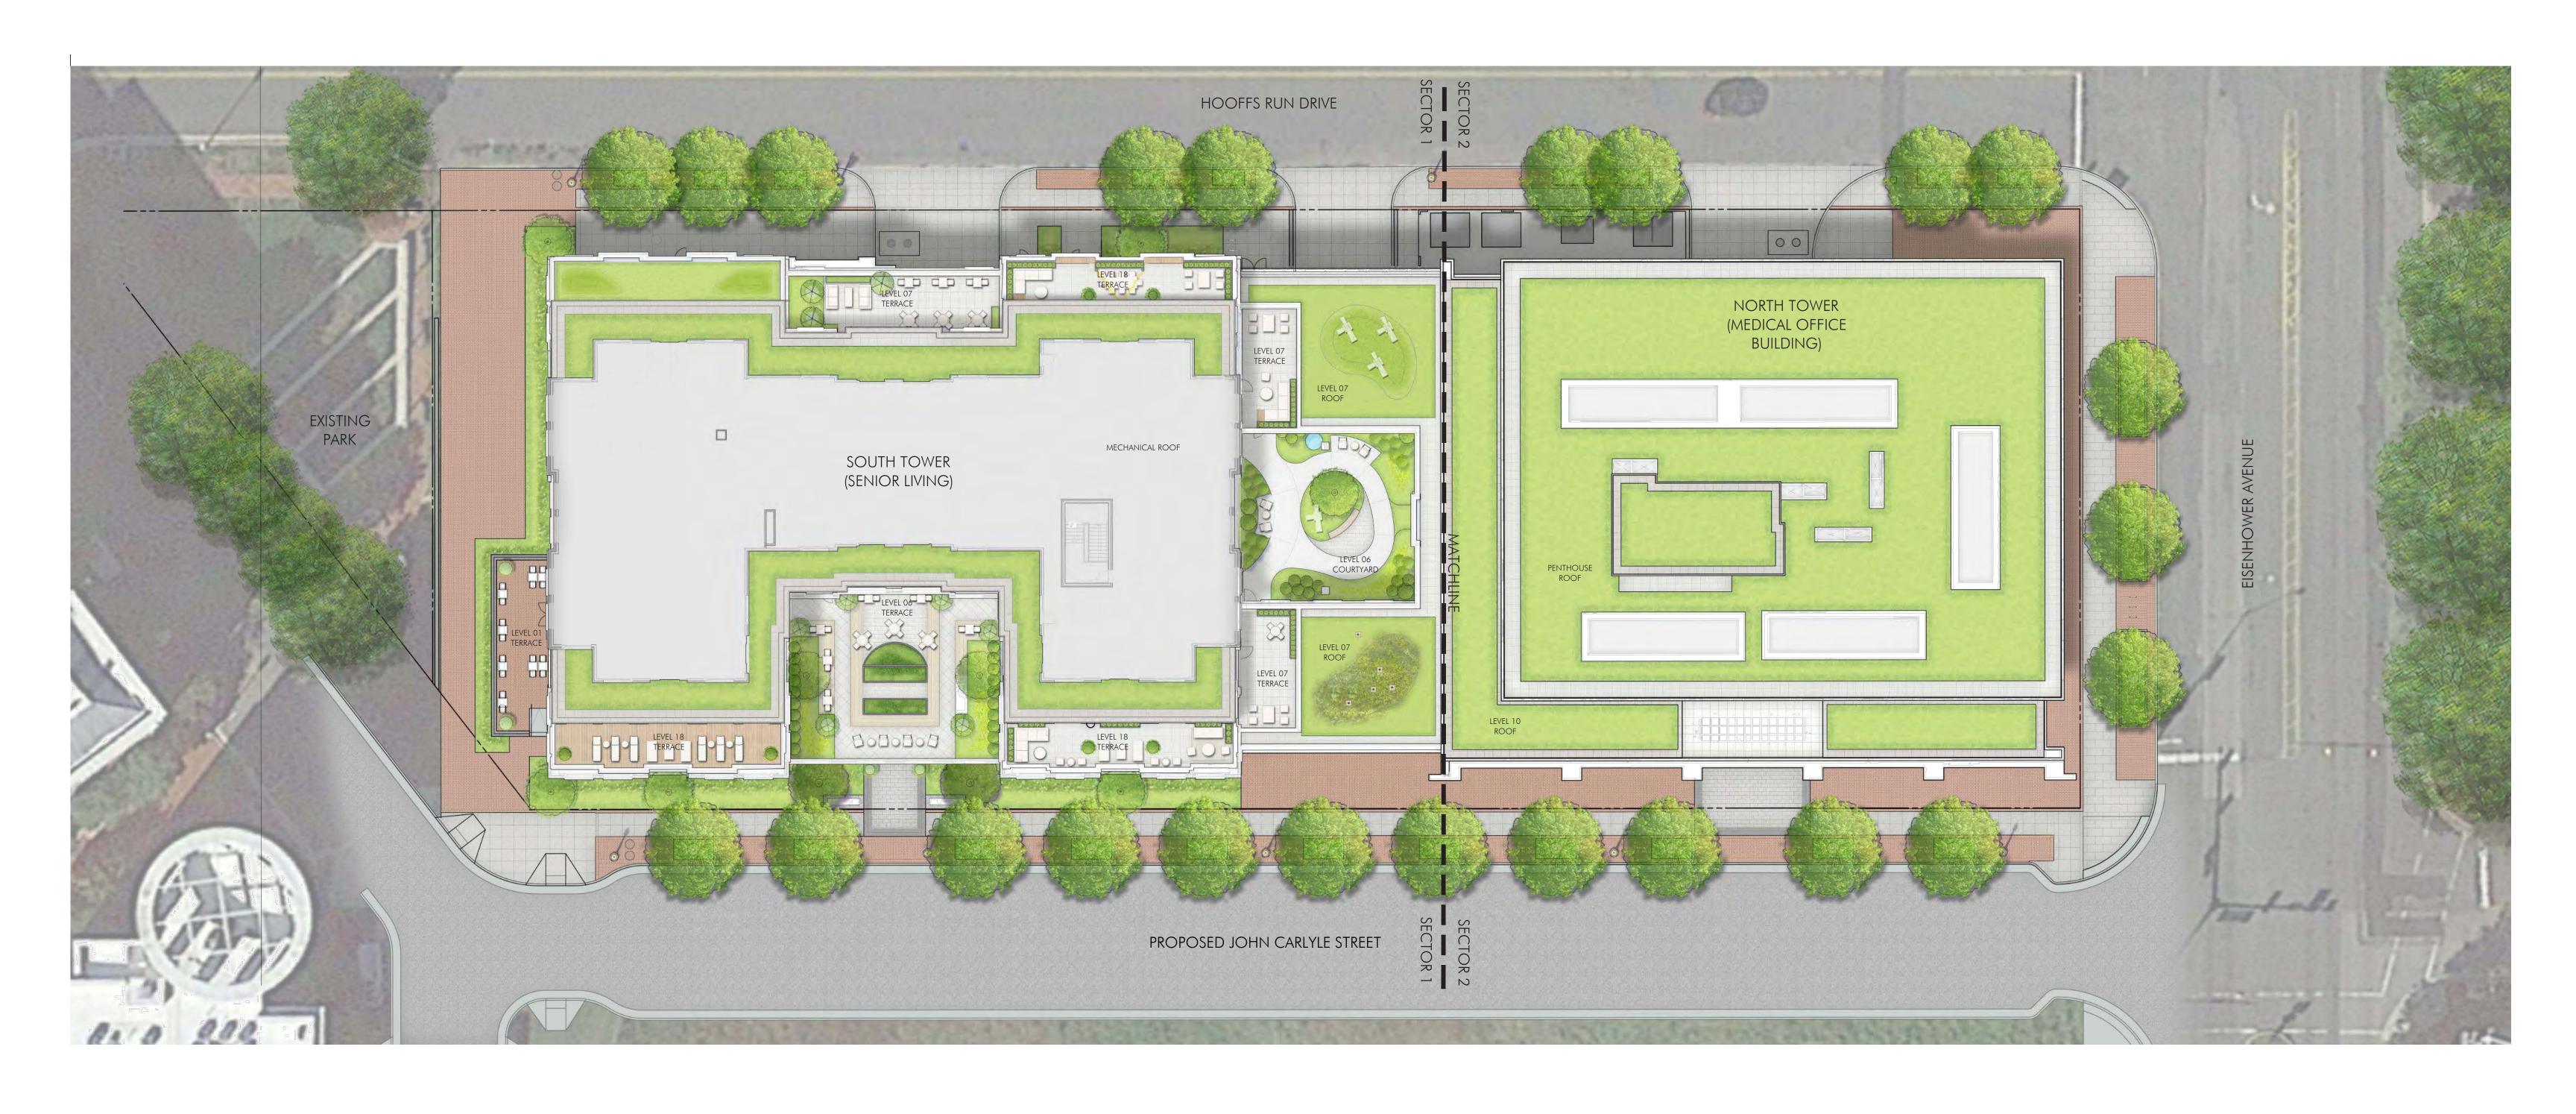

#### **OVERALL LANDSCAPE PLAN**





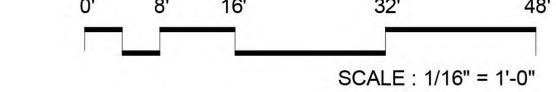




**6TH FLOOR - MEMORY CARE** 






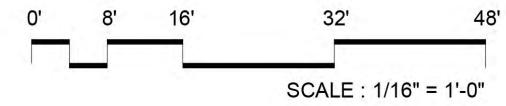





8TH - 10TH FLOOR - ASSISTED LIVING

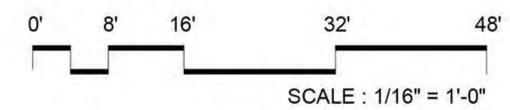







11TH - 17TH FLOORS - INDEPENDENT LIVING





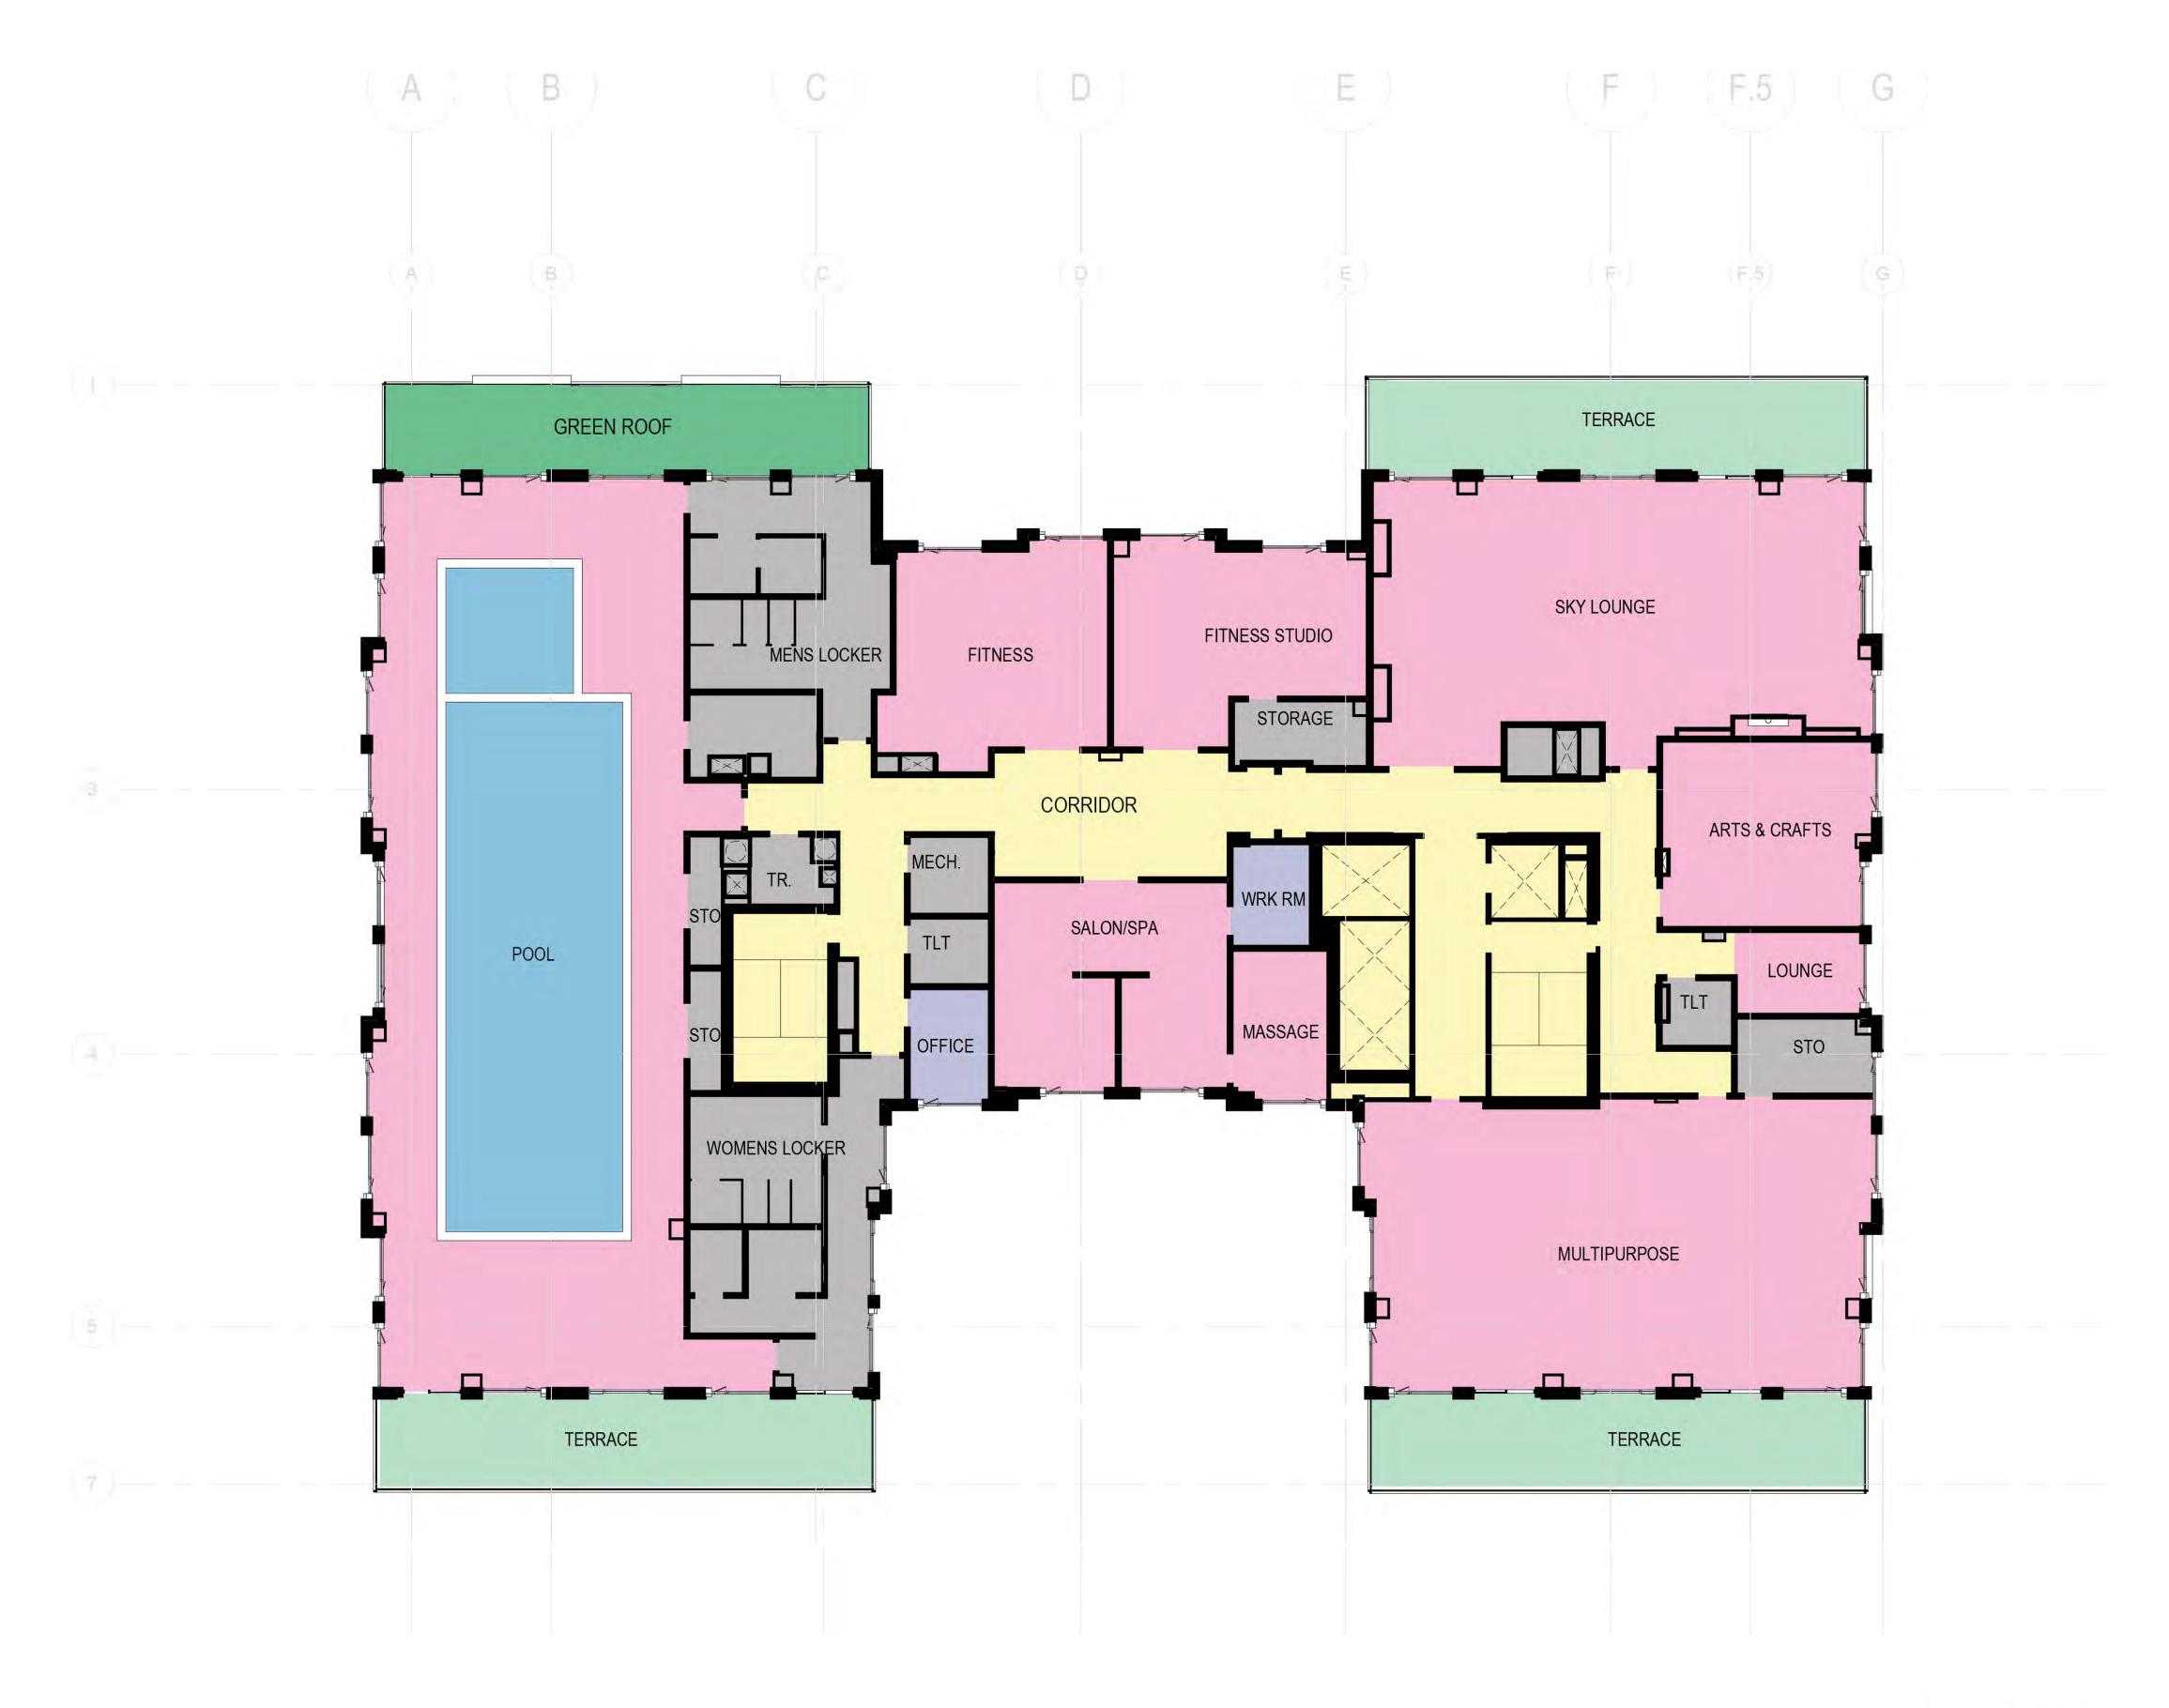



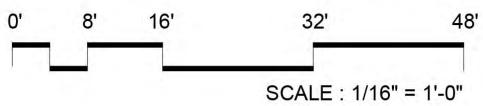













SOUTHEAST VIEW OF SOUTH TOWER



**EAST AERIAL PERSPECTIVE** 



EAST FACADE PERSPECTIVE



WEST AERIAL PERSPECTIVE



WEST FACADE PERSPECTIVE



**SOUTH AERIAL PERSPECTIVE** 



SOUTH FACADE PERSPECTIVE